


T. 33 S.
R. 1 E. & 1 W., W. M.

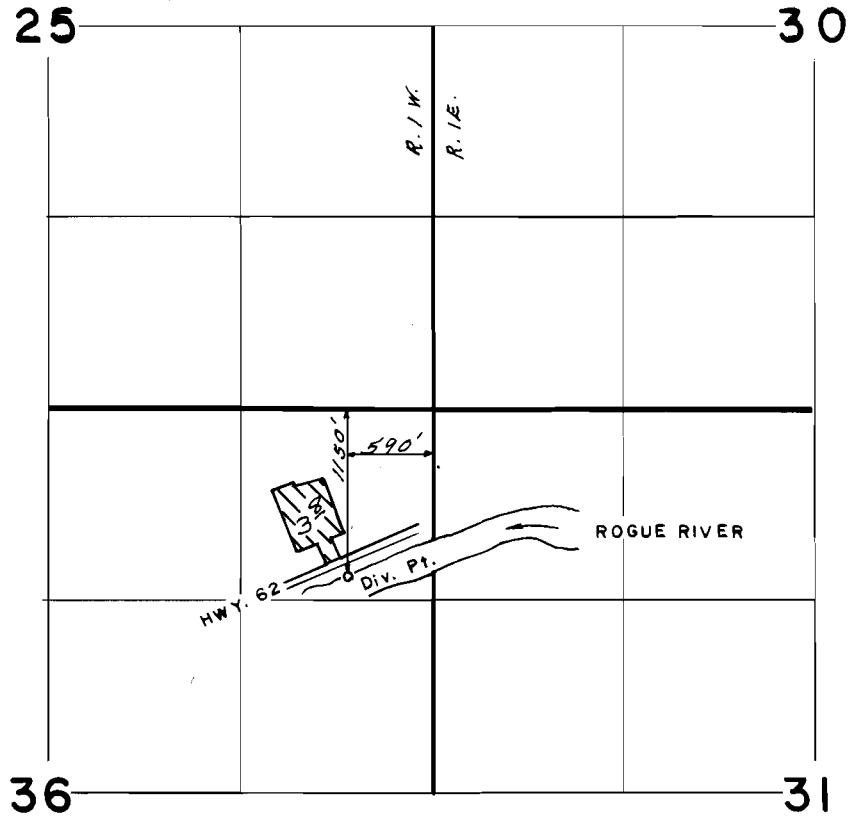

Scale: 1" = 1320'

FINAL PROOF SURVEY
UNDER

Application No. 61683 Permit No. 46564
IN NAME OF

ROBERT H. WETTER

Surveyed OCT. 15, 1985, by B. S. JAMES