


T. 37 & 38 S., R. 4 W., W.M.

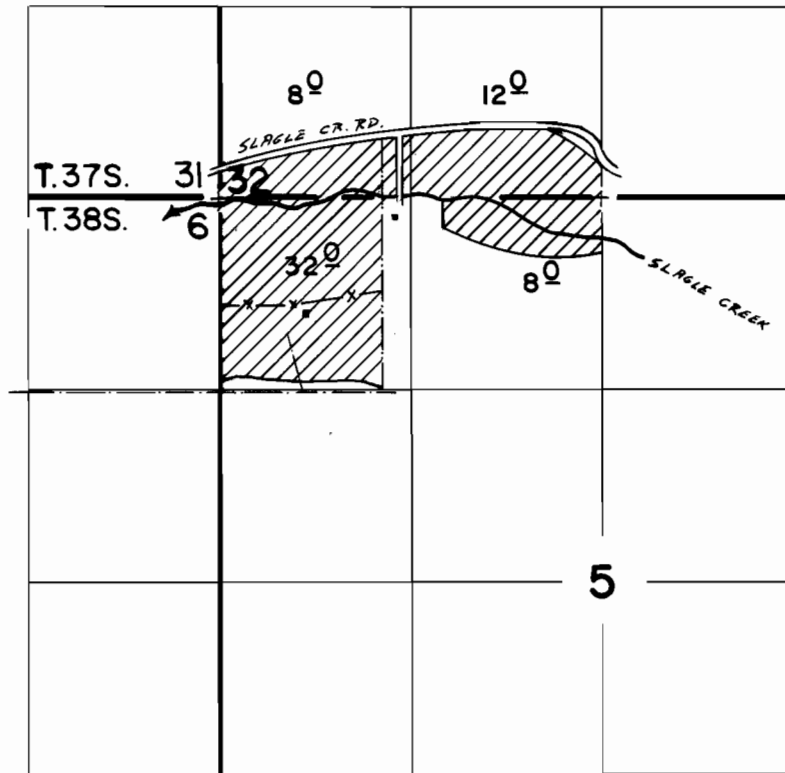

Scale 1" = 1320'

FINAL PROOF SURVEY UNDER

Application No. 63453 Permit No. 47359
IN NAME OF

JOHN ATKINS

Surveyed Oct. 8 1985, by B.S. JAMES

