


T. 37S., & T. 38S., R. 4 W., W.M.

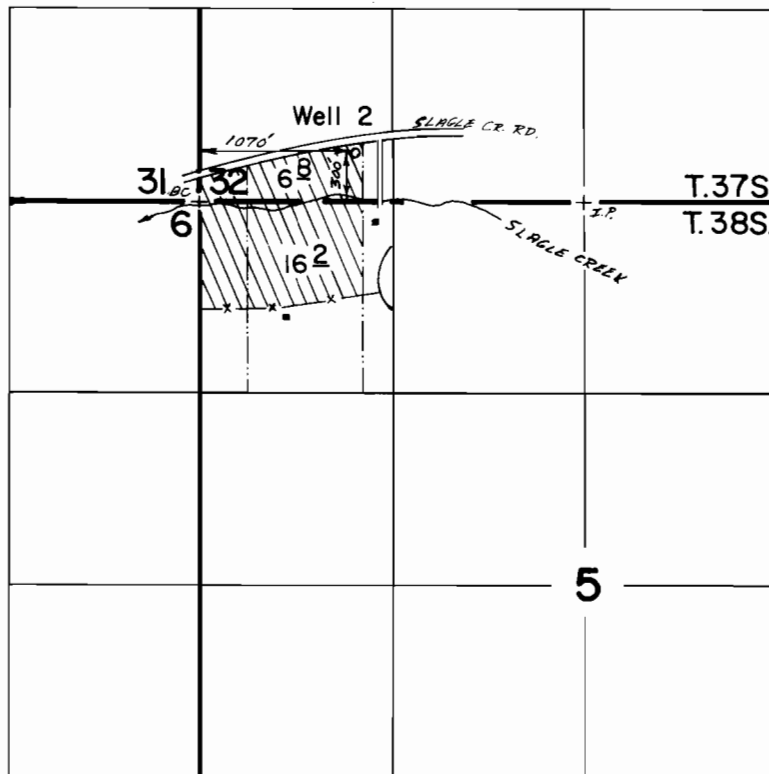

Scale 1"=1320'

FINAL PROOF SURVEY UNDER

Application No. G-9869 Permit No. G-9082
IN NAME OF

JOHN J. ATKINS

Surveyed Oct. 8, 1985, by B.S. JAMES