


T. 37S., & T. 38S., R. 4W., W.M.

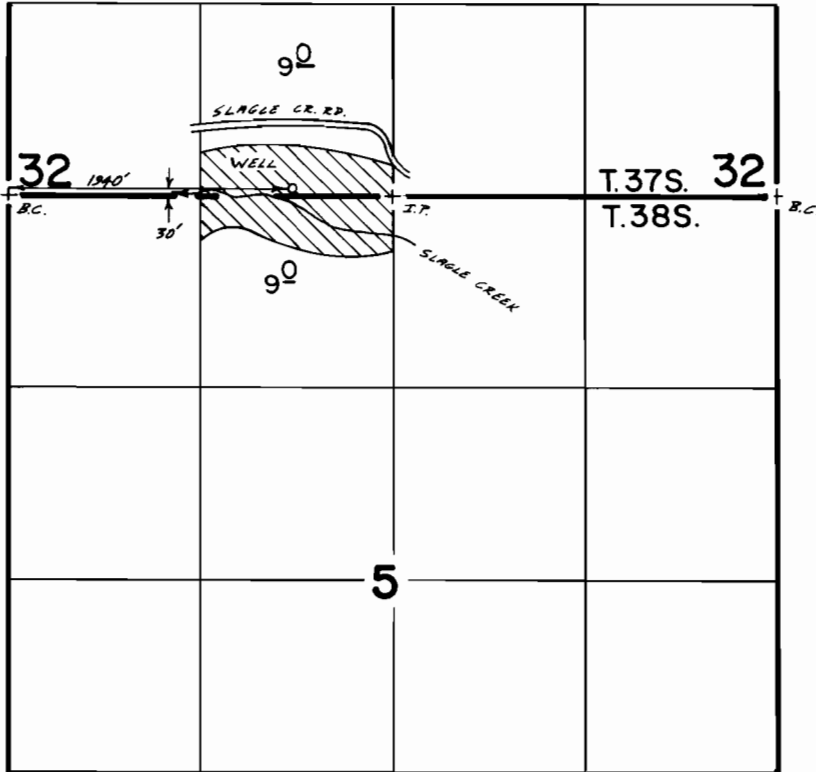

Scale 1" = 1320'

FINAL PROOF SURVEY UNDER

Application No. G-9868 Permit No. G-9130.....
IN NAME OF

...JOHN J. ATKINS.....

Surveyed Oct. 8, 1985, by B.S. JAMES.....