


T. 34 S., R. 1 W., W.M.
Sec. 3

NW 1/4 NE 1/4

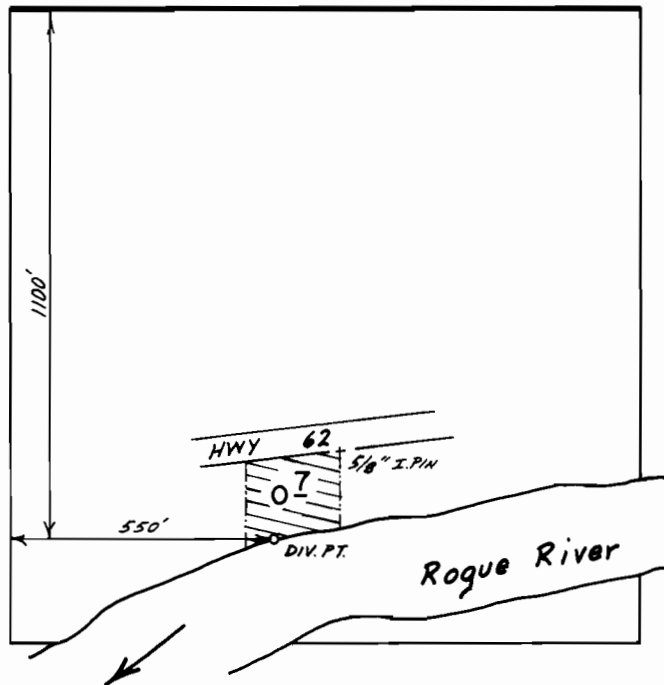

Scale 1" = 400'

FINAL PROOF SURVEY
UNDER

Application No. 65130 Permit No. 47577
IN NAME OF

WINFRED D. &/or OLA M. PARKER

Surveyed Nov. 5, 1985, by B.S. JAMES