


T. 38 S., R. 4 W., W.M.

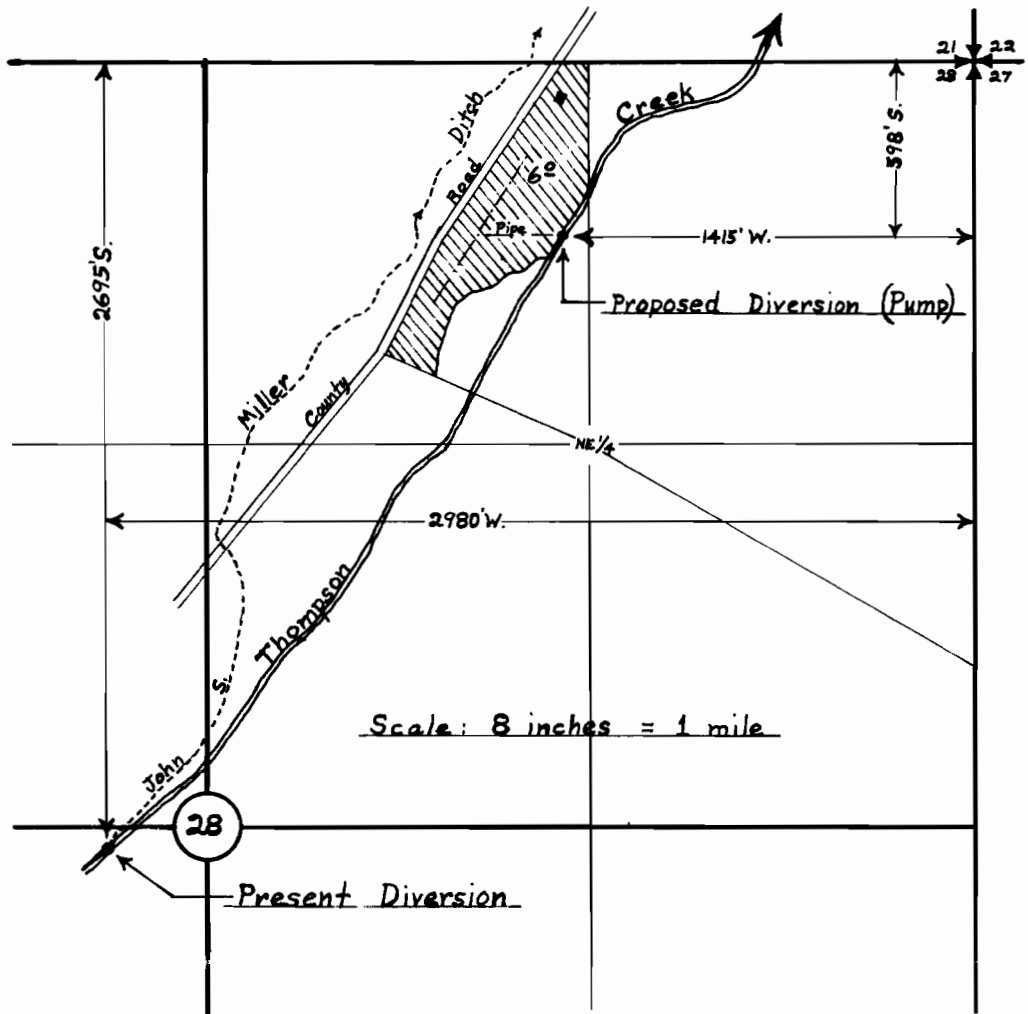

Map to accompany application in the name of Lloyd W. Burks, for a change in point of diversion of water from Thompson Creek.


This Office --- October 28, 1958.

David C. Hendrix, Watermaster Dist. #15.

b 101

Vernon P. & Charlotte Fowler
Change in point of diversion map...

T-5063

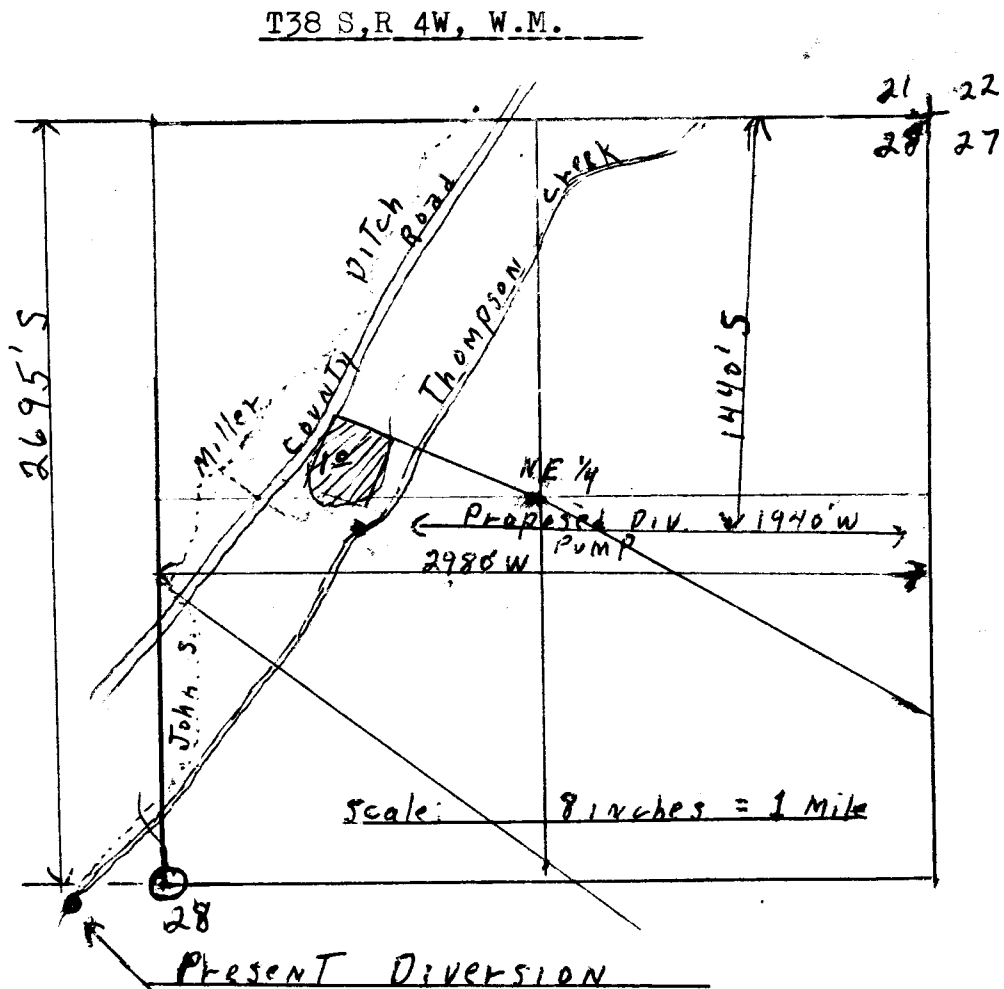

Map to accompany application in the name of Vernon P. & Charlotte Fowler, for a change in point of diversion of water from Thompson Creek.

RECEIVED

MAY 27 1982

WATER RESOURCES DEPT
SALEM, OREGON