


T. 35 S., R. 6 W., W.M.

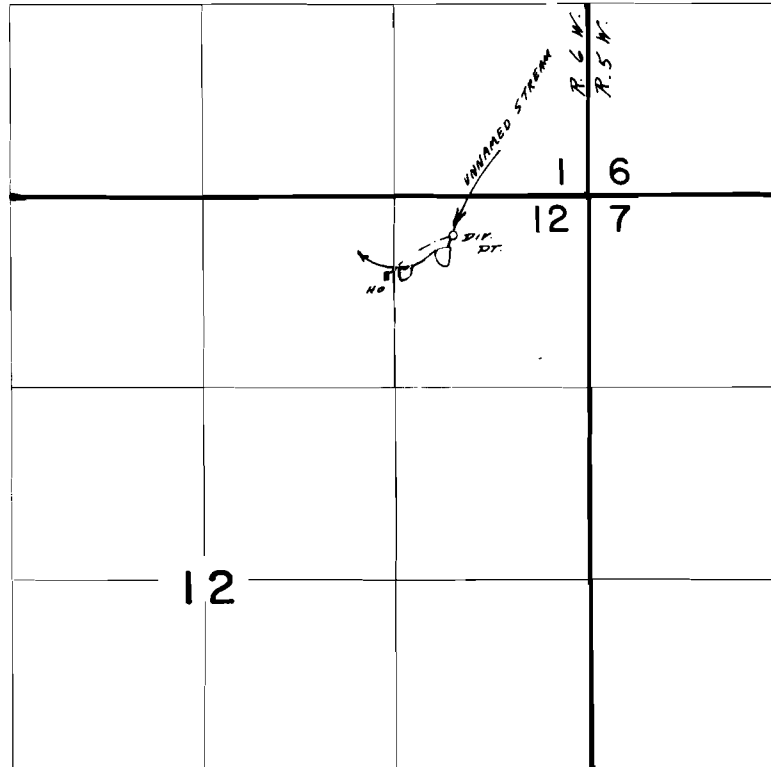

DIV. FROM STREAM:
270' S., 920' W. from
NE cor SEC 12.

SCALE : 1" = 1320'

FINAL PROOF SURVEY
UNDER

R-56170 R-6632
Application No. **56171** Permit No. **41959**
IN NAME OF

ART MILANI

Surveyed JUL 16, 1986, by B. S. JAMES