


T. 35 S., R. 6 W., W.M.

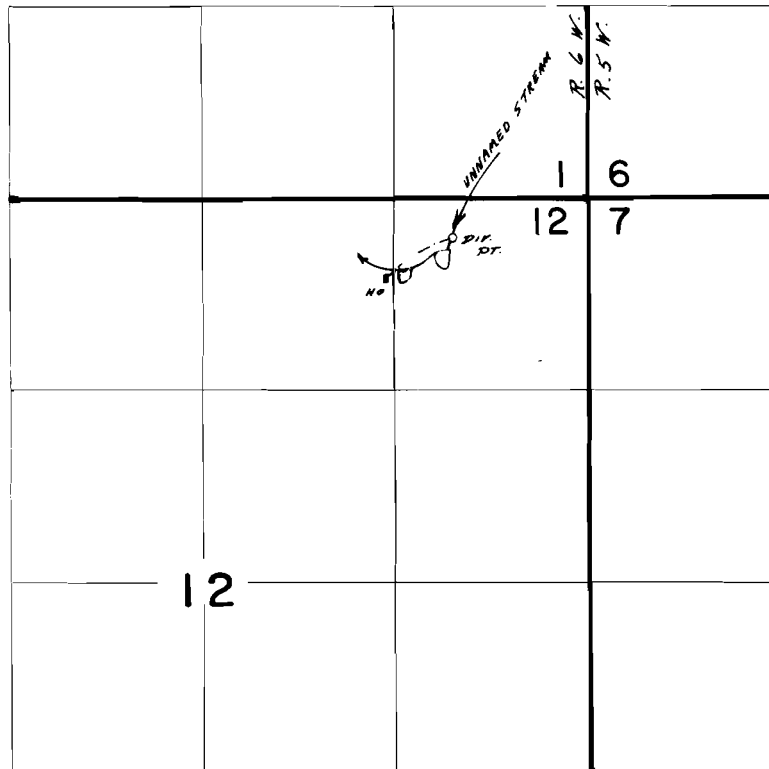

DIP. FROM STREAM:
270' S., 920' N. from
NE cor. Sec. 12.

SCALE : 1" = 1320'

FINAL PROOF SURVEY UNDER

R-56170 R-6632
Application No. 56171 Permit No. 41959
IN NAME OF

ART MILANI

Surveyed JUL 16 1986, by B. S. JAMES