


T. 37 S., R. 6 W., W.M.

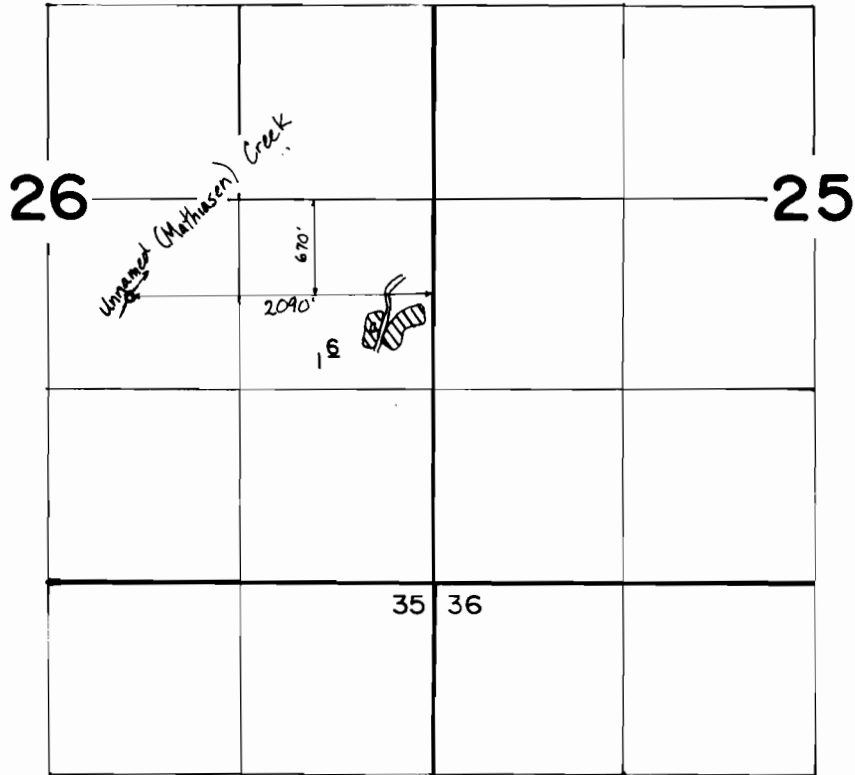

**FINAL PROOF SURVEY**  
UNDER

Application No. 48741... Permit No. 36558...  
IN NAME OF

**FRED W. SILER**

Surveyed JUNE 17, 1982., by B. R. SUND.