


T. 36 S.,
R. 6 & 7 W.,
W.M.

24

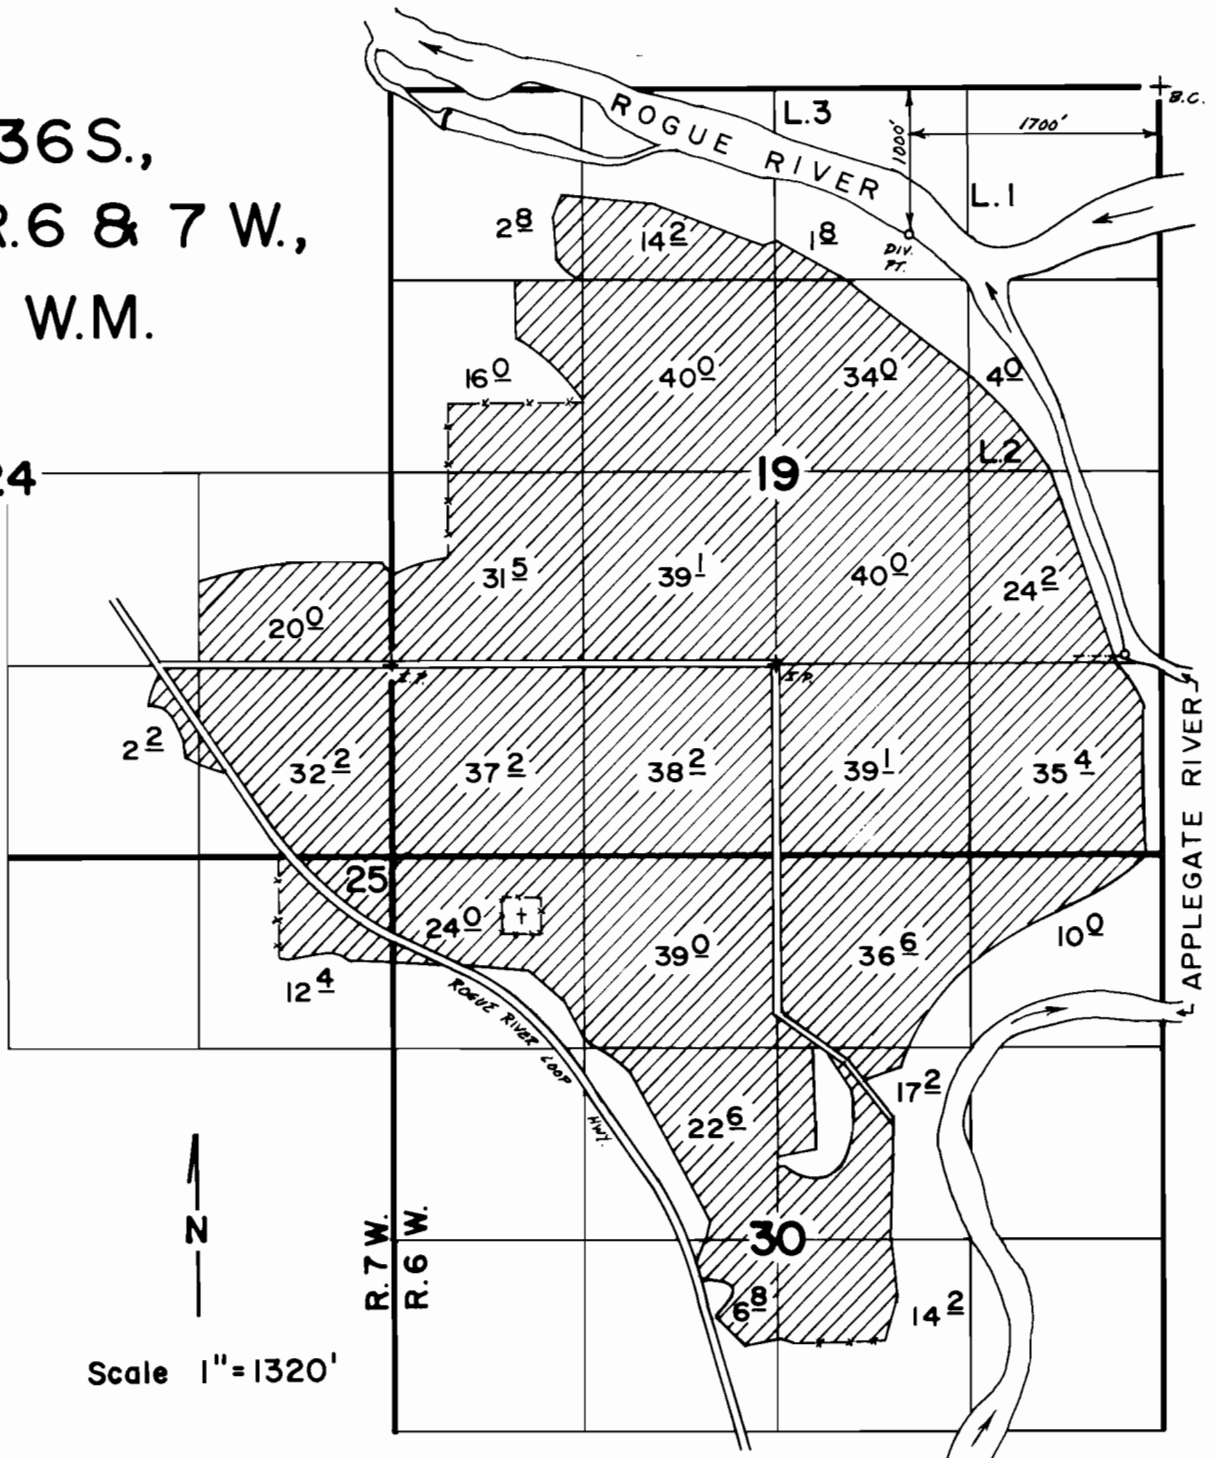

Scale 1" = 1320'

FINAL PROOF SURVEY
UNDER

Application No. 55239. Permit No. 41420.....
IN NAME OF

GENTRY E. MCKINNEY, SALVATORE T. PALMA, DAVID T. FAMA

Surveyed JAN. 24, 1984, by B.S. JAMES.....