


T. 36 S., R. 5 W., W.M.

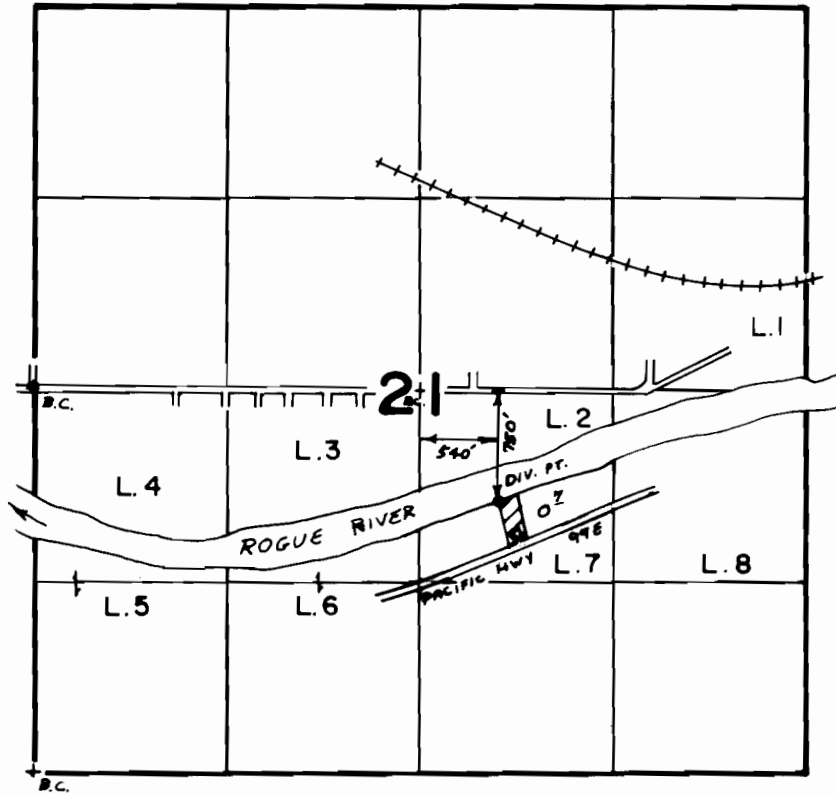

Scale 4" = 1 mile

FINAL PROOF SURVEY
UNDER

Application No. 60534. Permit No. 45310.....
IN NAME OF

.....*DR. CURTIS R. GAYLOR*.....

Surveyed Nov. 4, 1981, by Bruce R. Sund