
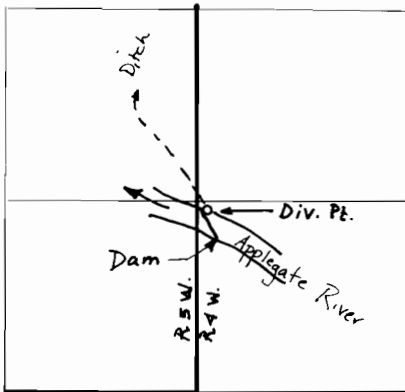


T. 37 S., R. 5 W., W.M.

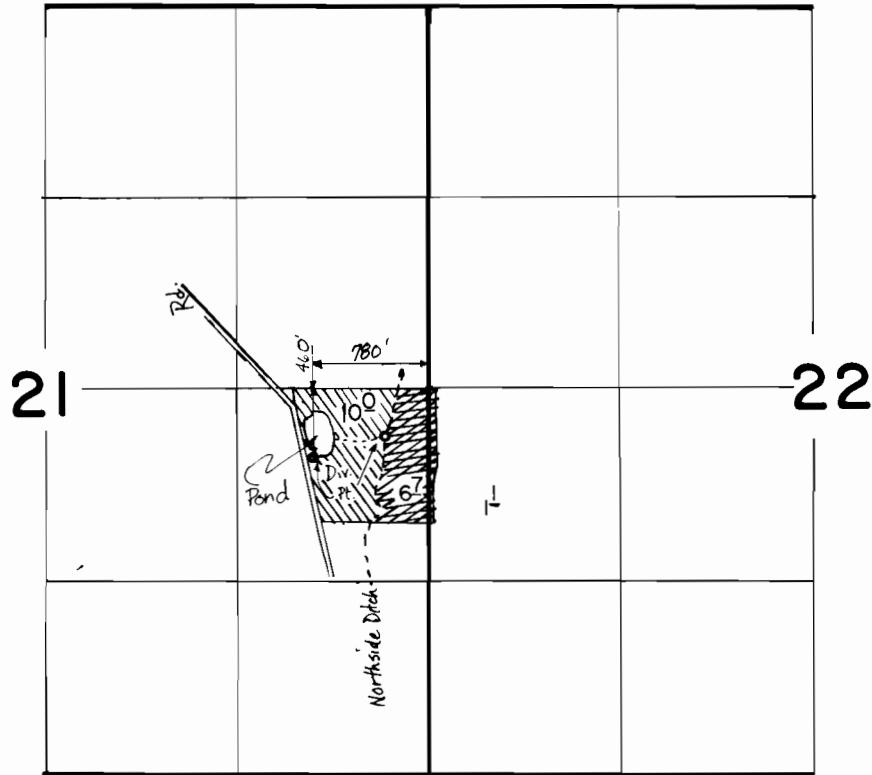

Div. Pt. located 4000' S. &  
80' E. from N.W. Cor.  
Sec. 6, T. 38 S., R. 4 W.

Scale: 4" = 1 mile

**FINAL PROOF SURVEY**  
UNDER

63416	46770	
62349	46624	
Application No. G-8896	Permit No. G-8313	

IN NAME OF

**EDGAR C. & PHYLLIS M. OWEN**

Surveyed Mar...29, 1982, by Bruce R. Sund.  
Aug. 18, 1983, B. S. JAMES