


T.15S. R.12W. W.M.

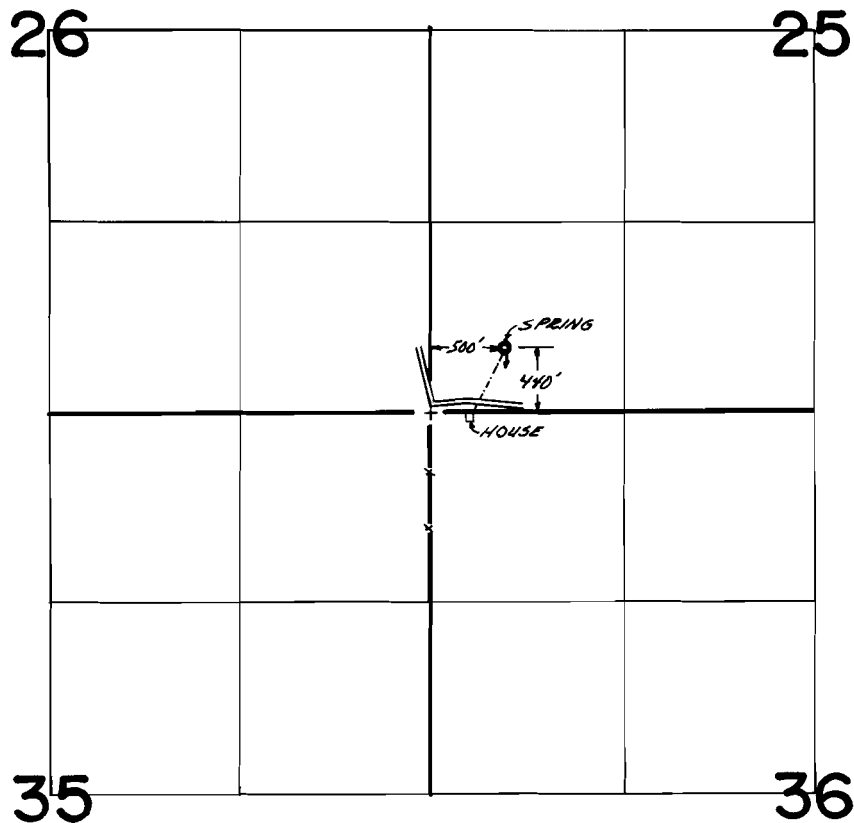

FINAL PROOF SURVEY
UNDER

Application No. 5.7.6.6.Q Permit No. 436.QI.....
IN NAME OF

GEORGE L. & NANCY C. HEILIGMAN

Surveyed AUG. 8, 1979, by S.C. BROWN.....