90684

T. 14S., R. 3W., W.M.

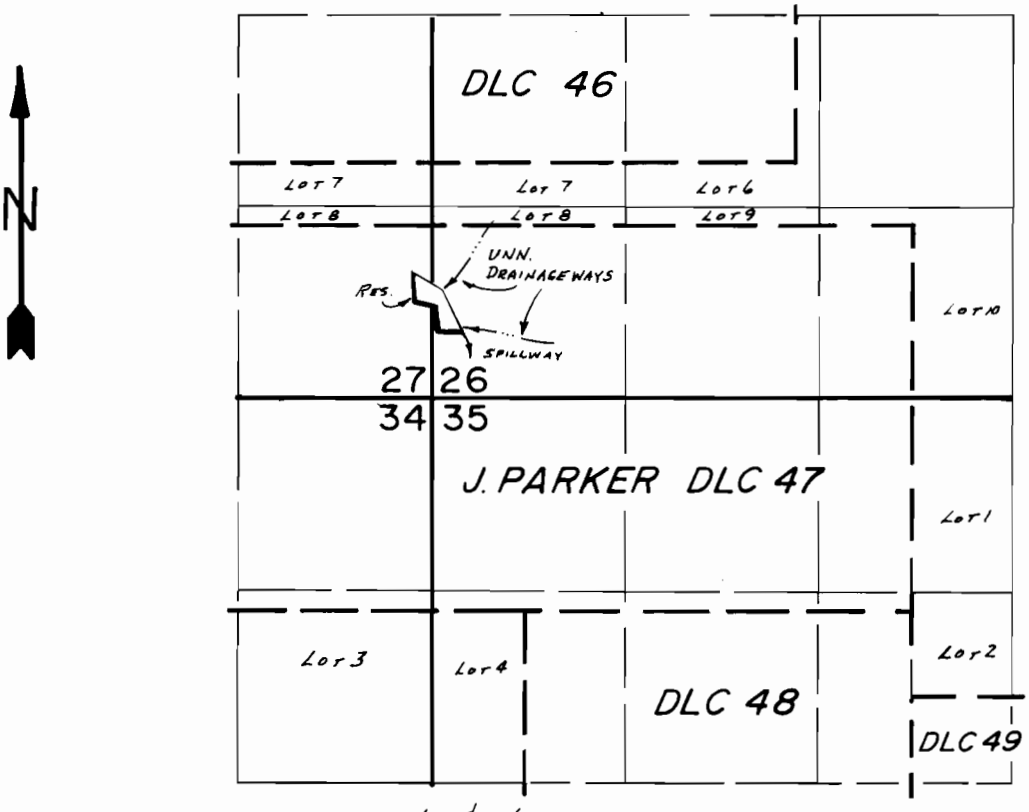

DAM LOC.: 640' N. & 30' E. FROM SW COR SEC. 26.

SCALE: 1" = 1320'

FINAL PROOF SURVEY

UNDER

R-59196 R-7843

Application No. 59197 **Permit No.** 44311

IN NAME OF

MICHAEL LAFFERTY

Surveyed June 16, 19 86, **by** B.W. BISHOP

11/19/86

PTS 19868