


T.14S., R.3W., W.M.

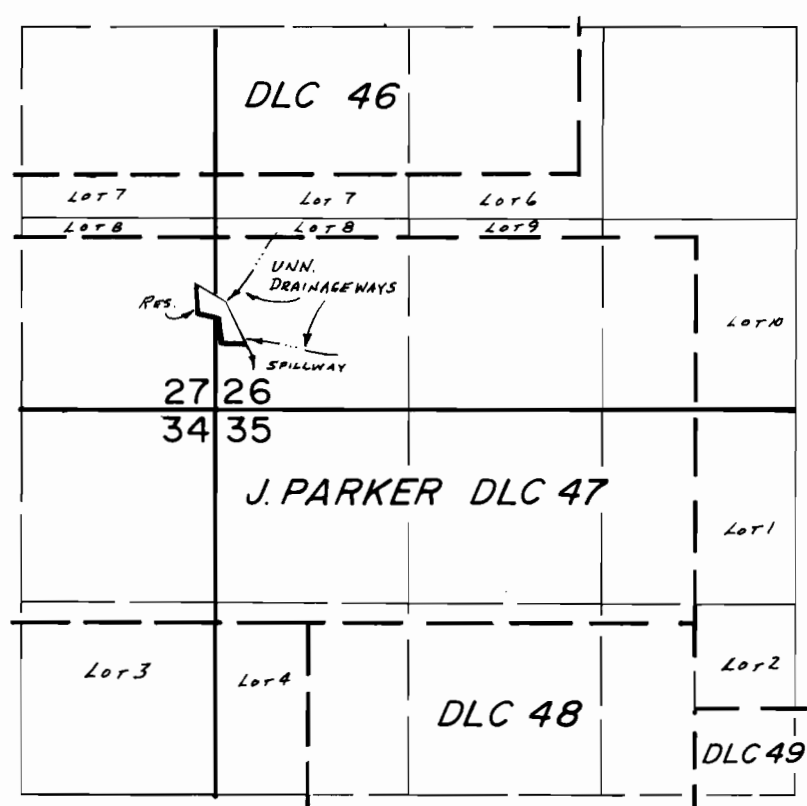

DAM LOC.: 640' N. & 30' E. FROM SW COR SEC. 26.

SCALE: 1" = 1320'

FINAL PROOF SURVEY UNDER

R-59196 R-7843
Application No. 59197... Permit No. 44311.....
IN NAME OF

.....MICHAEL LAFFERTY.....

Surveyed June 16, 1986, by B.W. BISHOP.....