


T. 10S., R. 1W., W.M.

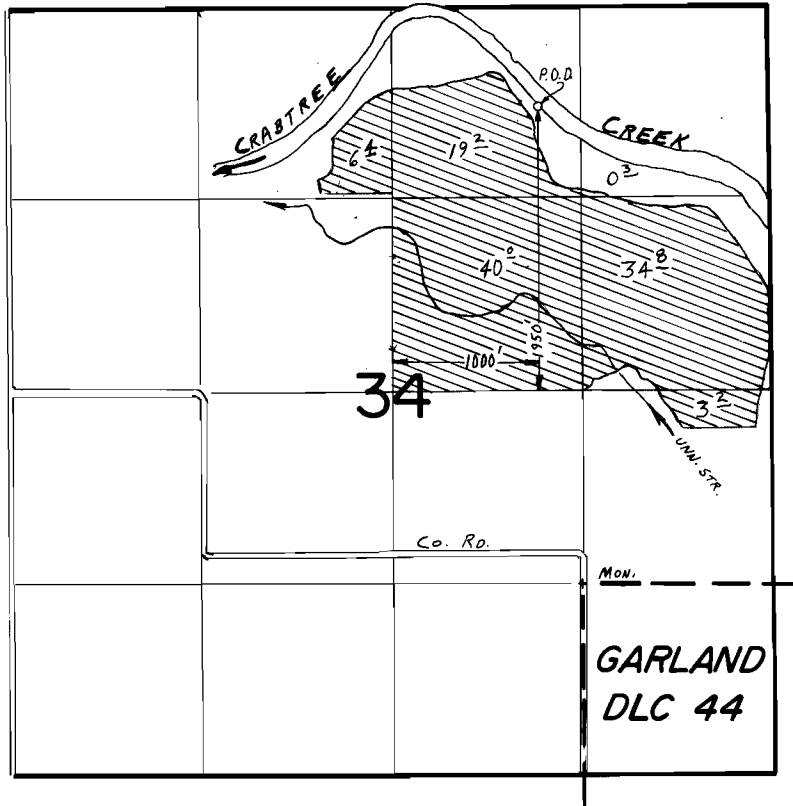

Scale : 1" = 1320'

FINAL PROOF SURVEY UNDER

Application No. 68059 Permit No. 48470.....

IN NAME OF

.....**JOSEPH R. FERY**.....

Surveyed May 9..... 1986., by T. Warren.....