


T. 10S., R. 1W., W.M.

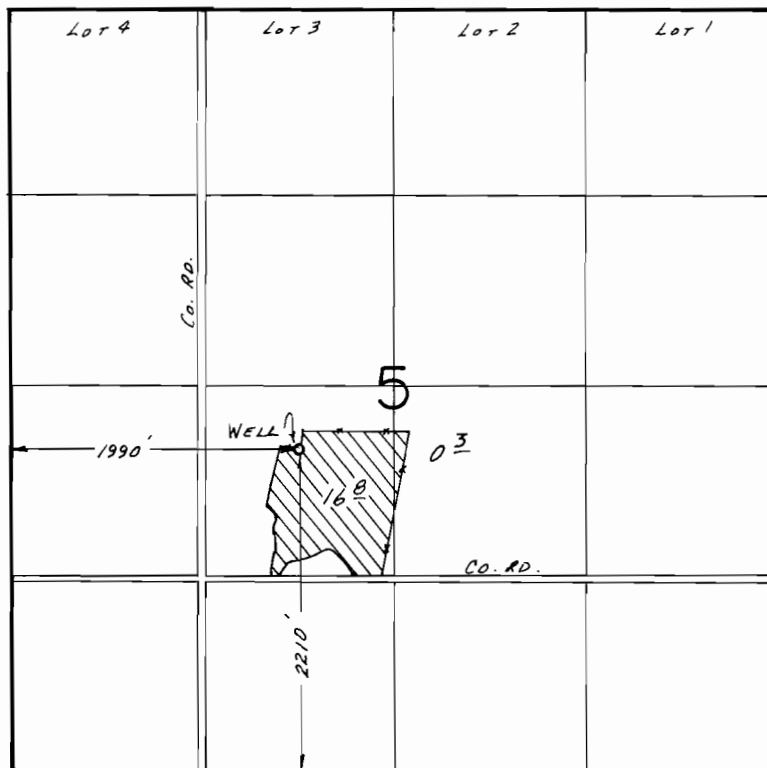

SCALE: 1"=1320'

FINAL PROOF SURVEY UNDER

Application No. G-9752 Permit No. G-9303....
IN NAME OF

.....ALAN M. HENDRICKSON.....

Surveyed May 28 1986, by B.W. BISHOP.....

11/12/86
BWB