


T.18S.,R.46E.,W.M.

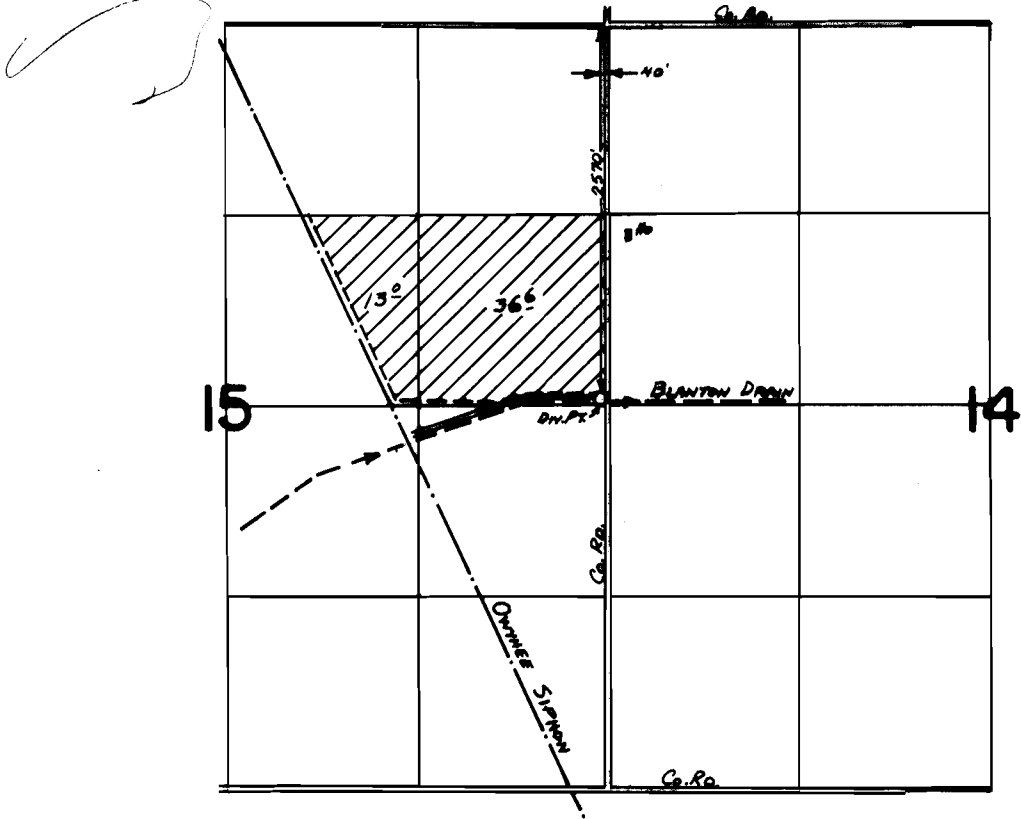

FINAL PROOF SURVEY
UNDER

Application No. .55906.. Permit No. .422U.....
IN NAME OF

.....**LAWERN KING**.....

Surveyed Aug..24.. 1983., by ..L..M..TOLL.....