


T.9S., R.2E., W.M.

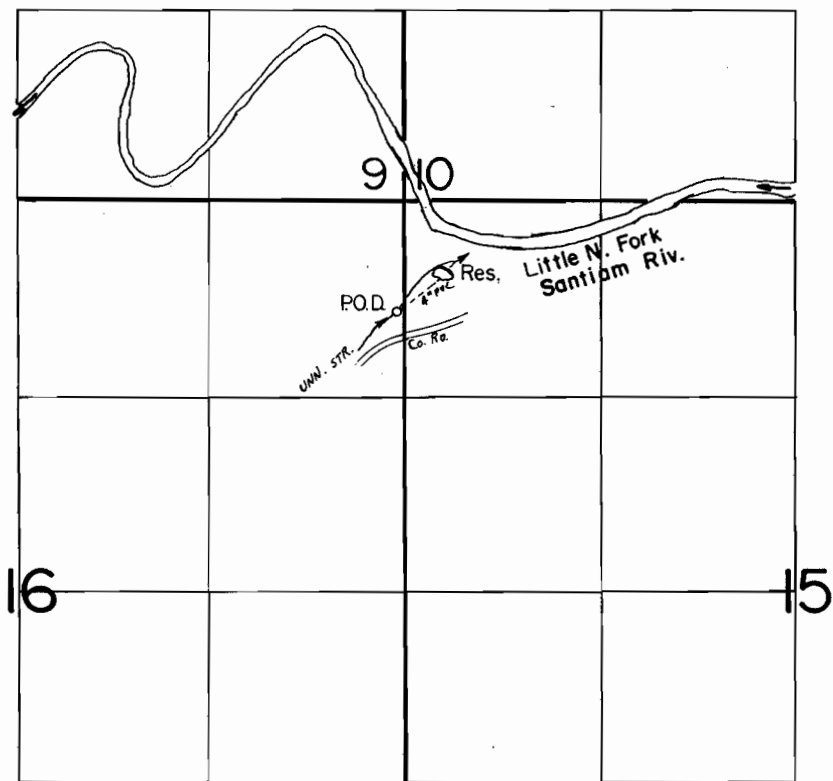

P.O.D. Loc. 760' S. & 50' W. from NE Cor. Sec. 16.

Scale: 1" = 1320'

FINAL PROOF SURVEY
UNDER

R-65181 R-8661
Application No. 65182... Permit No. 47588.....

IN NAME OF

ROBERT P. MOBLEY

Surveyed May...2.... 1986, by J. Warren.....

41047-178-41 A
+ Zoom
TMW 11/24/86