


T.6&7S. R.1E., W.M.

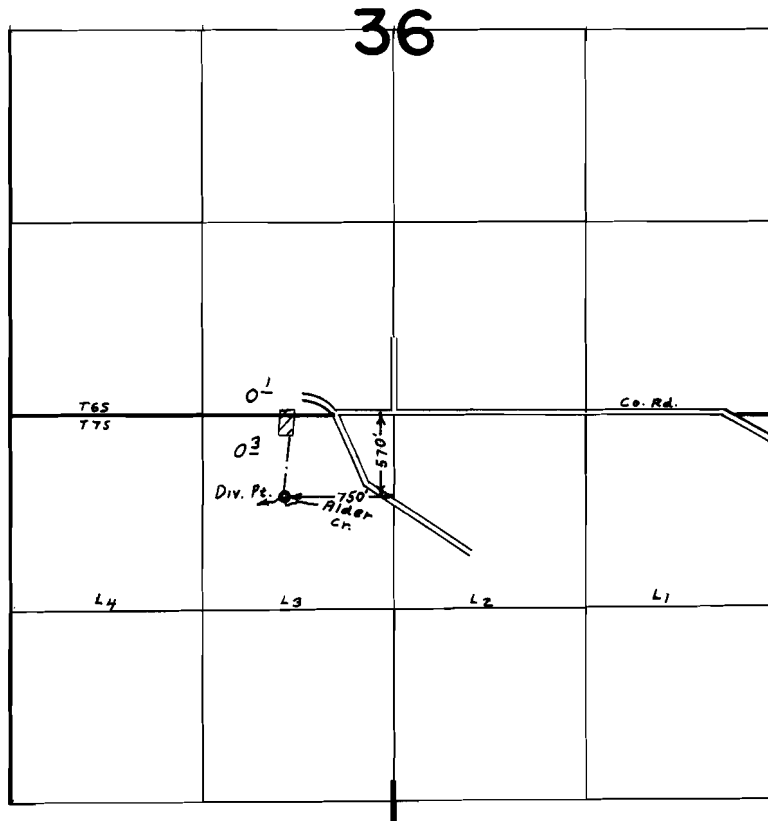

FINAL PROOF SURVEY
UNDER

Application No. 50576... Permit No. 38182.....
IN NAME OF

..... FRANCIS M. BIELENBERG

Surveyed JUN. 5..... 1979., by L. H. NUNN.....