


T. 6 & 7 S. R. 1 W. W.M.

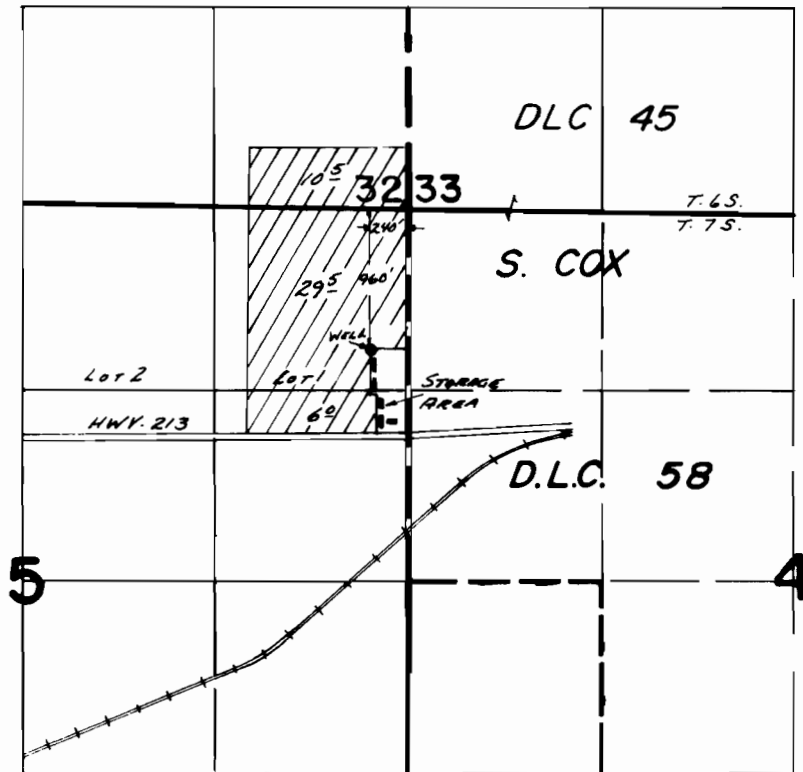

FINAL PROOF SURVEY UNDER

Application No. G-5484 Permit No. G-5388
IN NAME OF

ROBERT E. DETTWYLER

Surveyed Sept. 6, 1979, by G.R. RODRIGUEZ