


T. 7S. R. 2W. W.M.

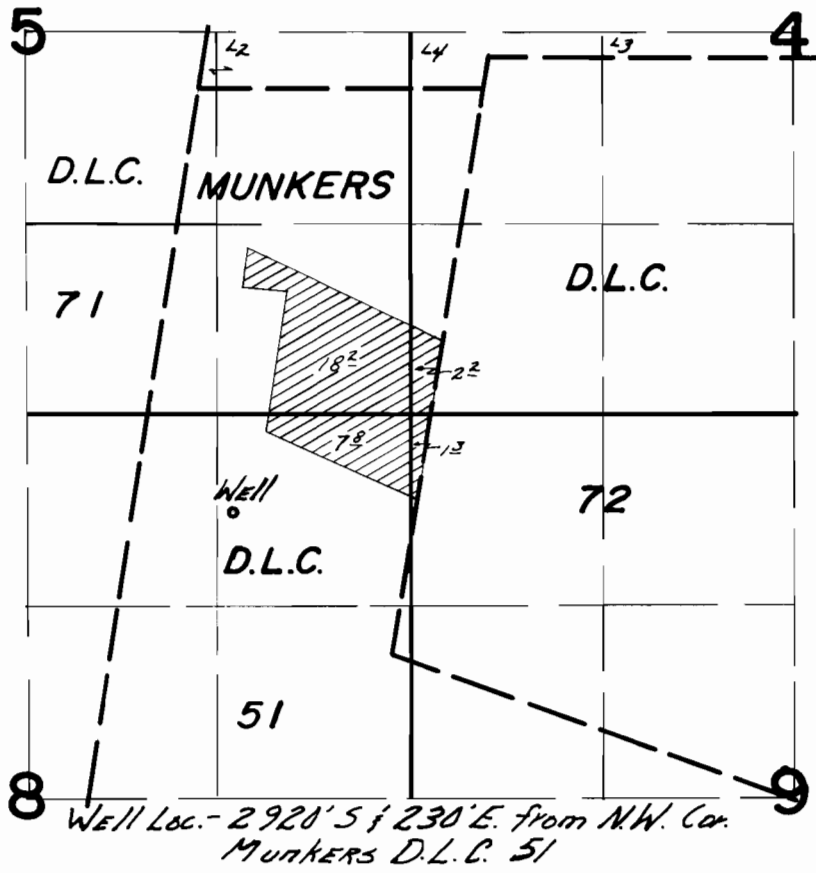

**FINAL PROOF SURVEY**  
UNDER

Application No. G-7247 Permit No. G-6651  
IN NAME OF

MELVIN VANCLEAVE

Surveyed Sept. 4, 1979, by C.R.RODRIGUEZ