


T.7S. R.2W., W.M.

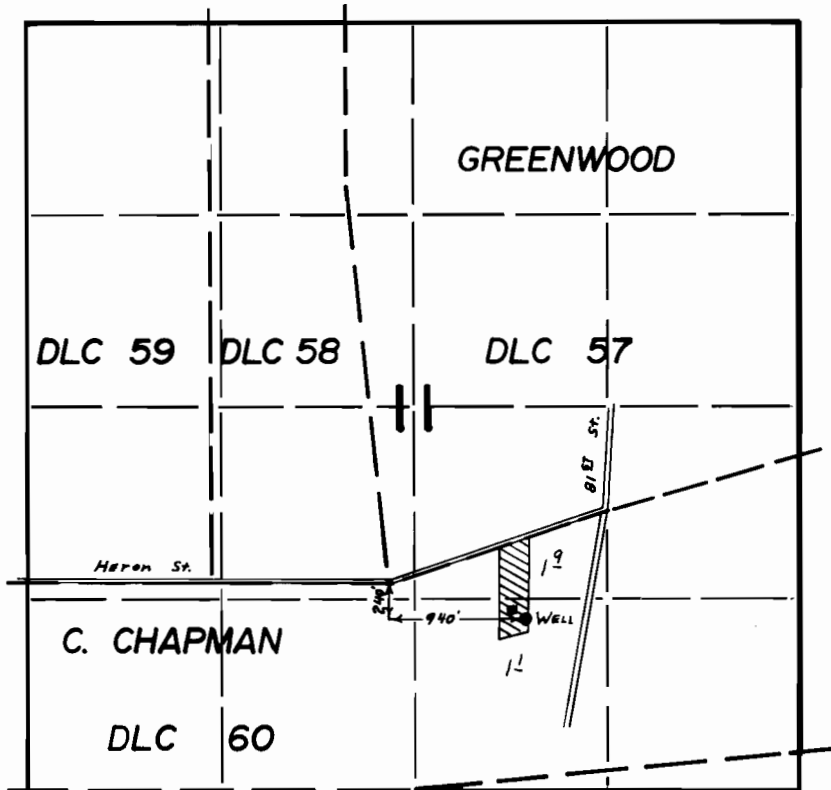

FINAL PROOF SURVEY UNDER

Application No. ~~G-7340~~ Permit No. ~~G-6805~~.....
IN NAME OF

.....**GEORGIANA HOMER**.....

Surveyed **MAY 17**, 1979., by **L. H. NUNN**.....