


T. 6S. R. 2W. W.M.

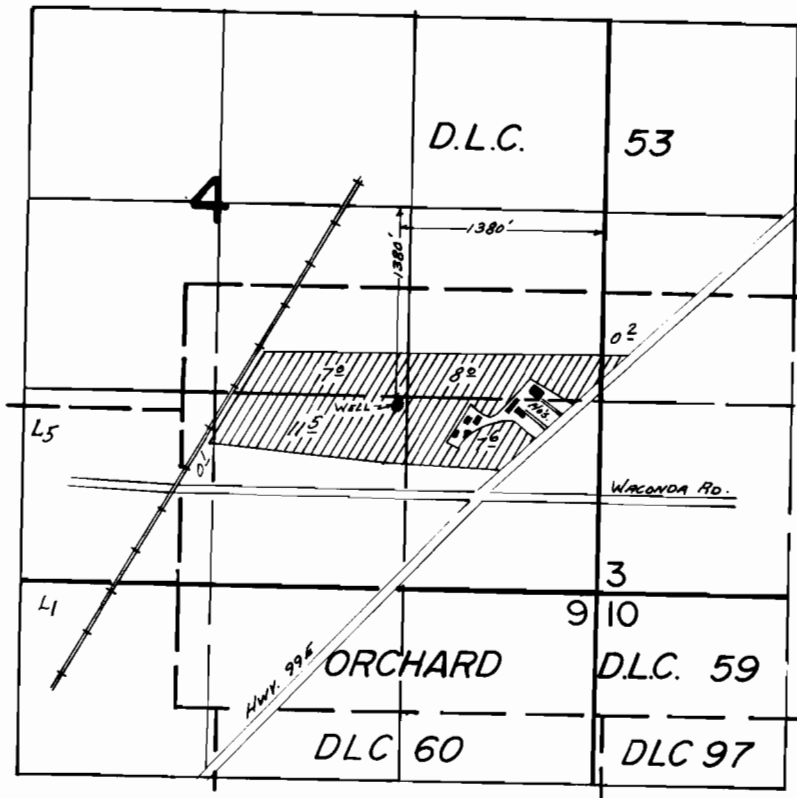

FINAL PROOF SURVEY
UNDER

Application No. G-7347. Permit No. G-6807.
IN NAME OF

ROBERT A. & PEGGY A. MACARTHUR

Surveyed Oct. 4, 1979, by C.R. RODRIGUEZ.