


T. 7S. R. 1W. W.M.

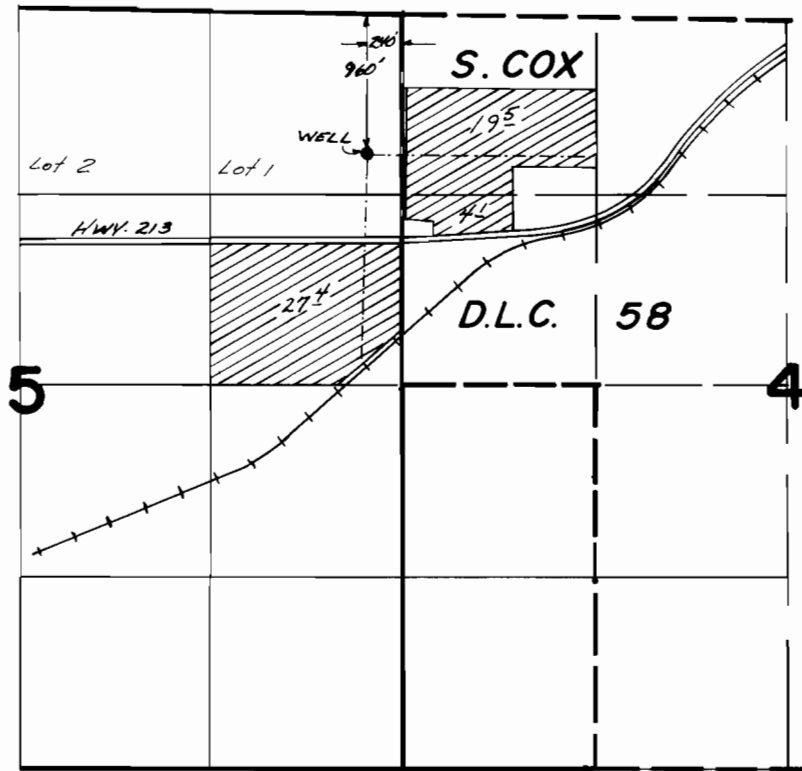

**FINAL PROOF SURVEY**  
UNDER

Application No. G-7797. Permit No. G-7232.  
IN NAME OF

BLUE LINE FARMS, INC.

Surveyed Sept. 6, 1979, by C.R. RODRIGUEZ.