



T.4N., R.26E., W.M.

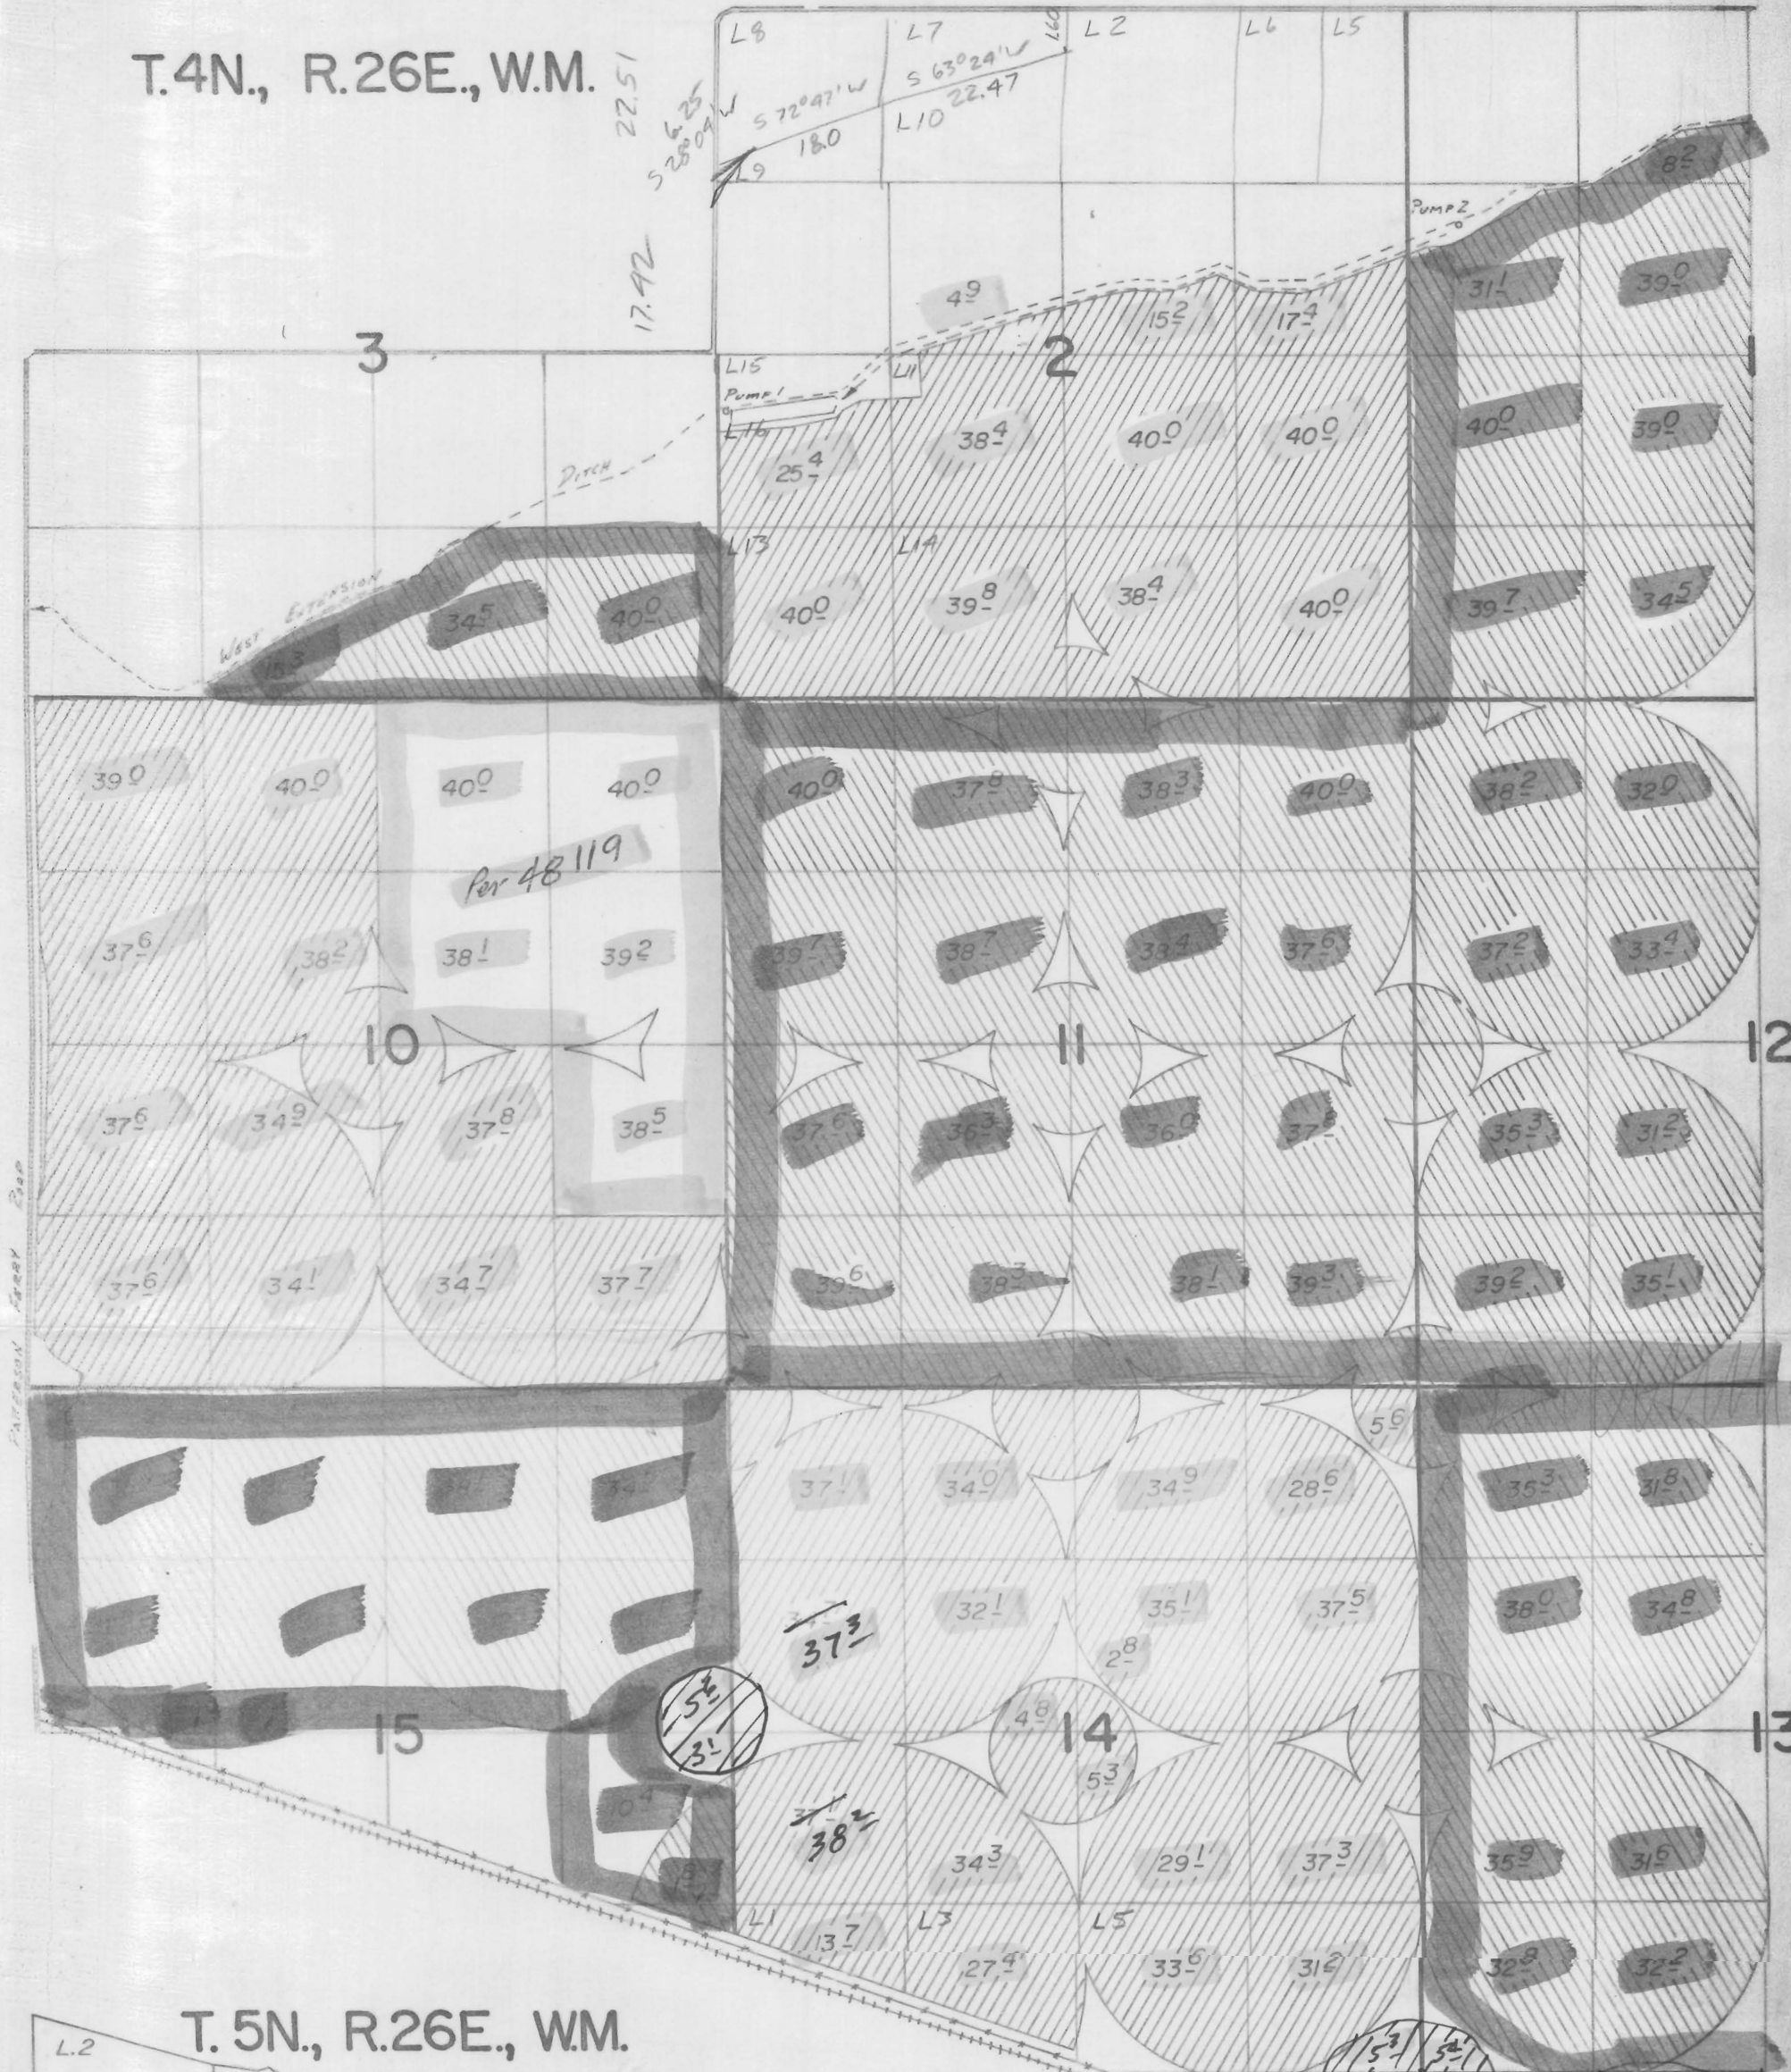

T.5N., R.26E., W.M.

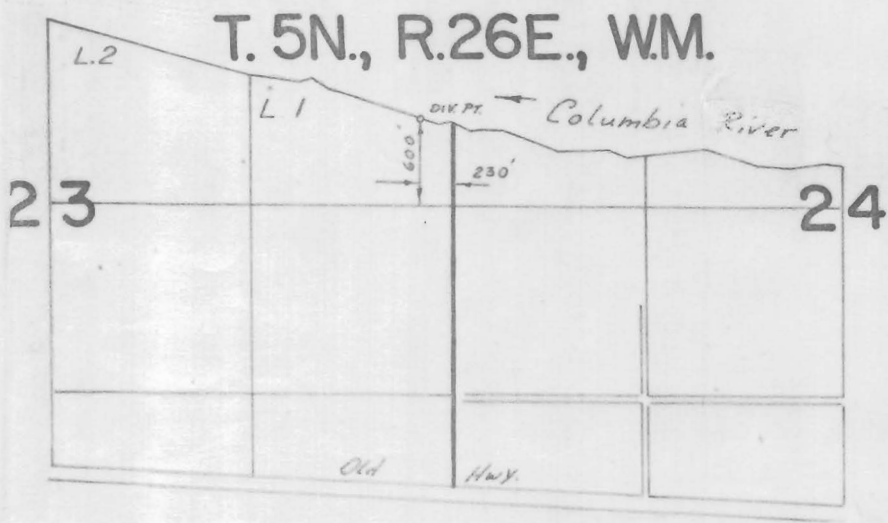

FINAL PROOF SURVEY

UNDER

APPL. 43956 PER. 32309
58394 44511

IN NAME OF
WESTERN EMPIRES CORP.

Surveyed 2-24 1981, by V.L. Church
8-31 1983.