


T. 3N. R. 29E.W.M.

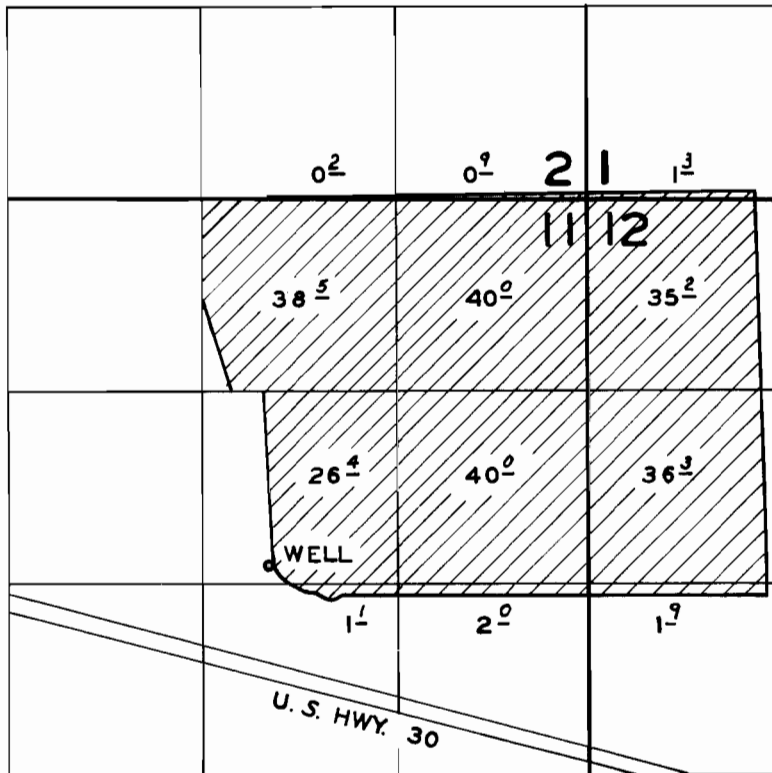

FINAL PROOF SURVEY
UNDER

Application No. U 802 Permit No. U714
IN NAME OF

CLAUDE O. MEYERS

Surveyed JULY 22 19 60, by *[Signature]*