


T.6N., R.35E., W.M.

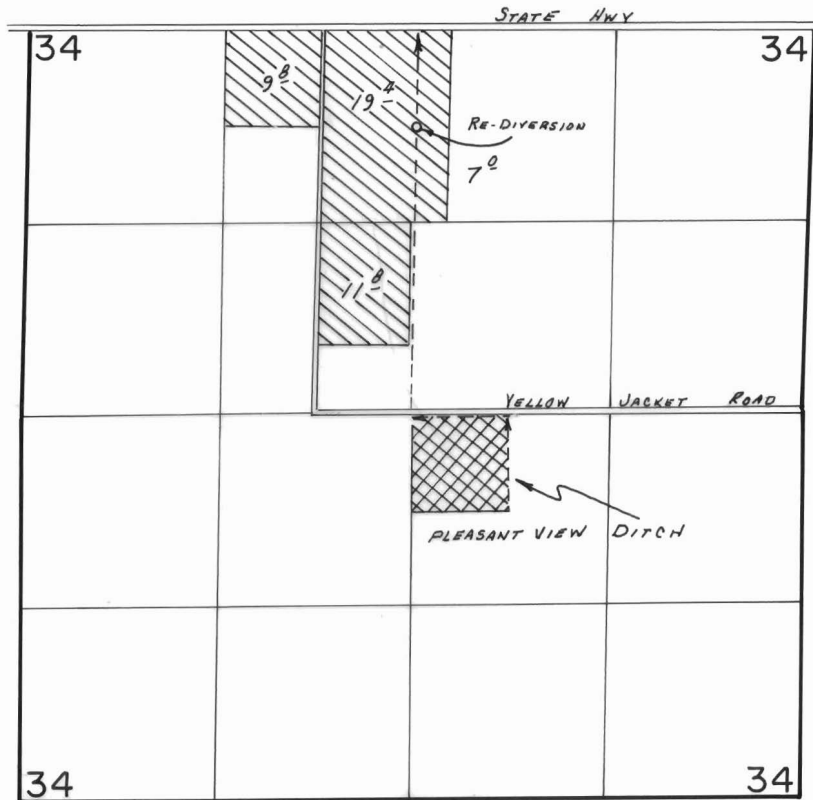

SCALE: 1" = 1320'

- SOURCE OF SUPPLY
- PLACE OF USE

FINAL PROOF SURVEY UNDER

Application No. 58998. Permit No. 44746.....
IN NAME OF

.....JAMES A. REESE.....

Surveyed Oct. 8..... 19.80, by V. CHURCH.....