


G-7742
36167

T. 1N. R. 32E. W.M.

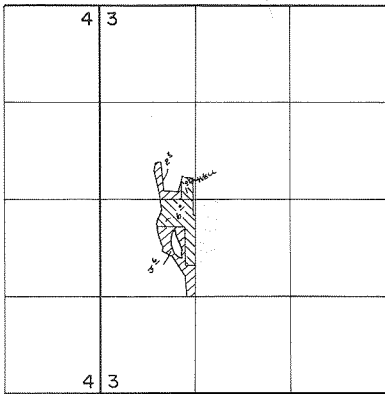

WELL LOCATED 1250' EAST AND 250' NORTH FROM WEST 1/4 COR. SEC. 3



PER. G-7829

PER. G-7742

FINAL PROOF SURVEY

UNDER

G-8210

G-7829

Application No. G-8210.. Permit No. G-7742.....

IN NAME OF

PHIL. D. BECK

Surveyed Jan. 27..... 1984, by Y.L. Church.....