


T. 4S., R. 39&40E., W.M.

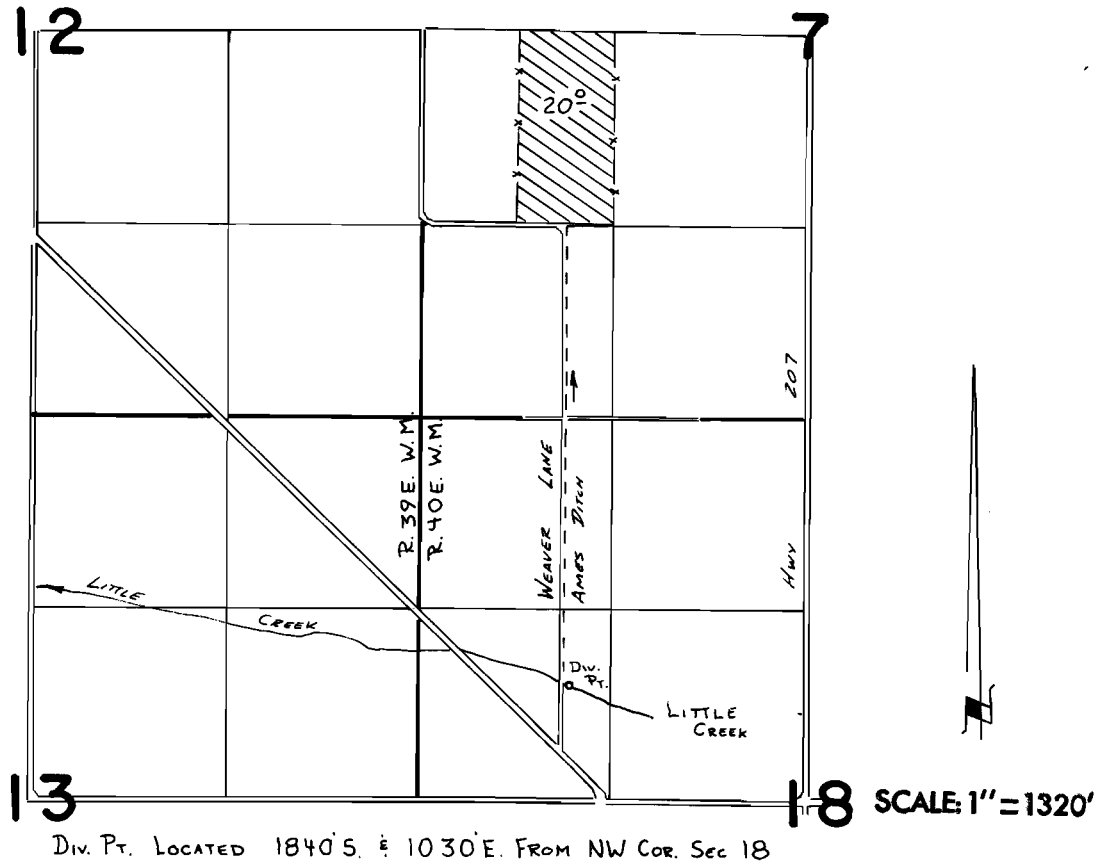

FINAL PROOF SURVEY
UNDER

Application No. **58886** Permit No. **44377**
IN NAME OF

DENNIS W. & COLLEEN LANGFORD

Surveyed **July 9, 1984**, by **V. L. Church**