


# T. IN. R. 4 W. W. M.

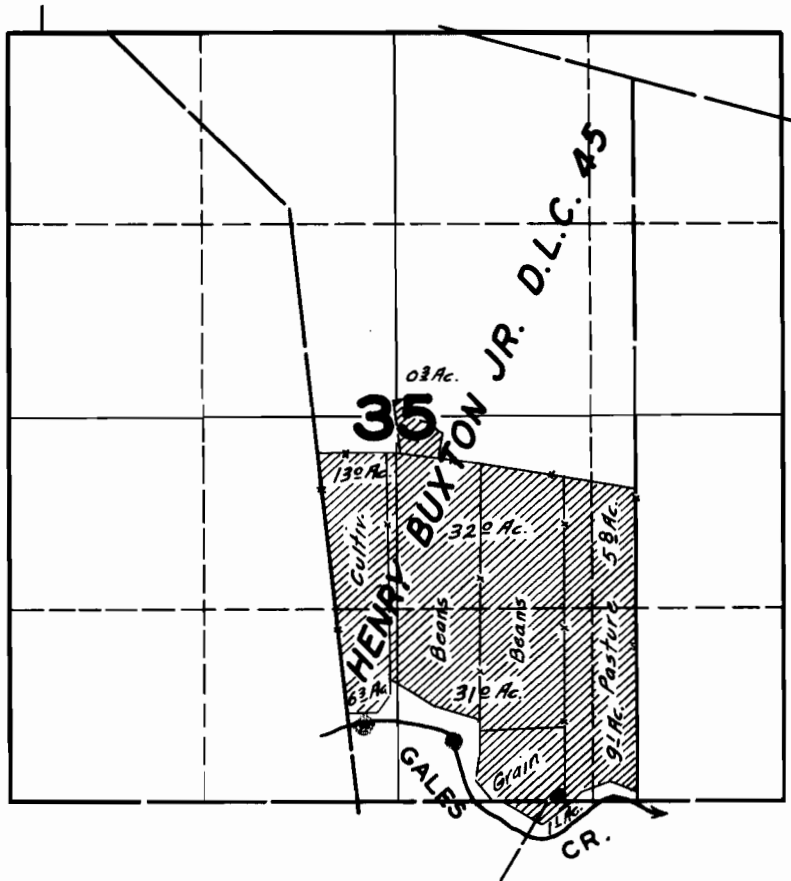

## FINAL PROOF SURVEY UNDER

Application No. 17888 Permit No. 13583  
IN NAME OF

E. A. RUETER

Surveyed JULY 2, 1947, by JAS. E. BUNNELL