


T. 1S., R. 2W., W.M.

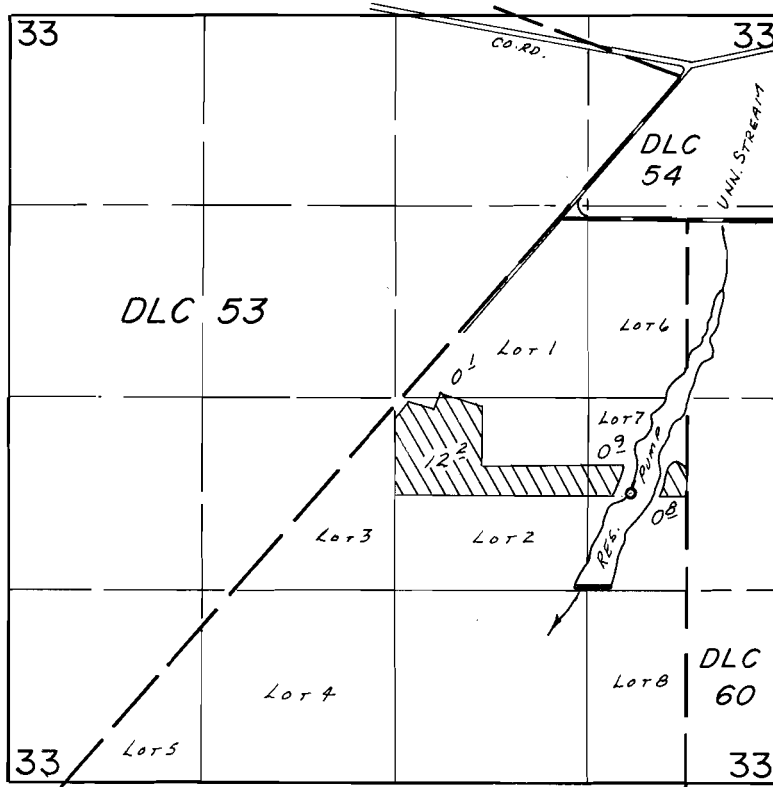

DAM LOC.: 1300'S. & 1275' W. FROM E. 1/4 COR SEC. 33.

SCALE: 1" = 1320'

FINAL PROOF SURVEY UNDER

Application No. 59810.. Permit No. 44717.....
IN NAME OF

.....JOSEPH & MARIE JACKSON.....

Surveyed JULY 15... 1986, by B.W. BISHOP.....

11/28/84
BWB