


T.5S., R.3W., W.M.

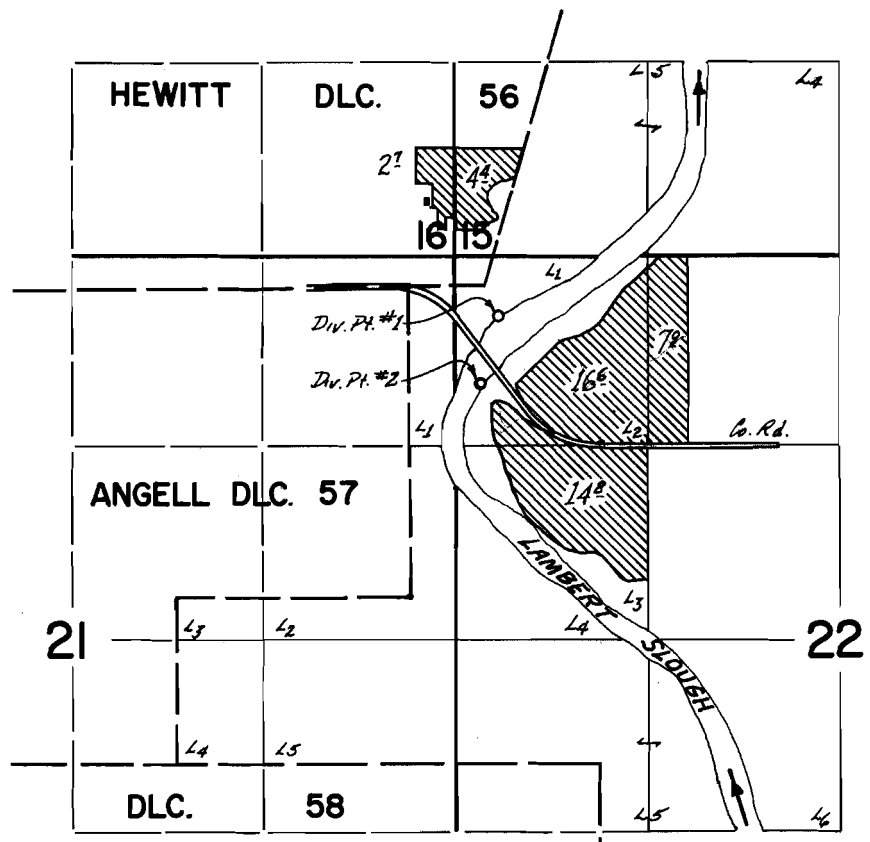

Div. Pts. located: #1 - 190' S. of 600' E.; #2 - 670' S. of 480' E.  
from the NE corner Angell DLC. 57.

**FINAL PROOF SURVEY**  
UNDER

Application No. 43588 Permit No. 32593  
IN NAME OF

ARNOLD HILDEBRANDT & H. B. or LYLA M. STEINGRUBE

Surveyed 8 Nov. 1972, by D. NORBY