




T. 4 S., R. 2 E., W.M.

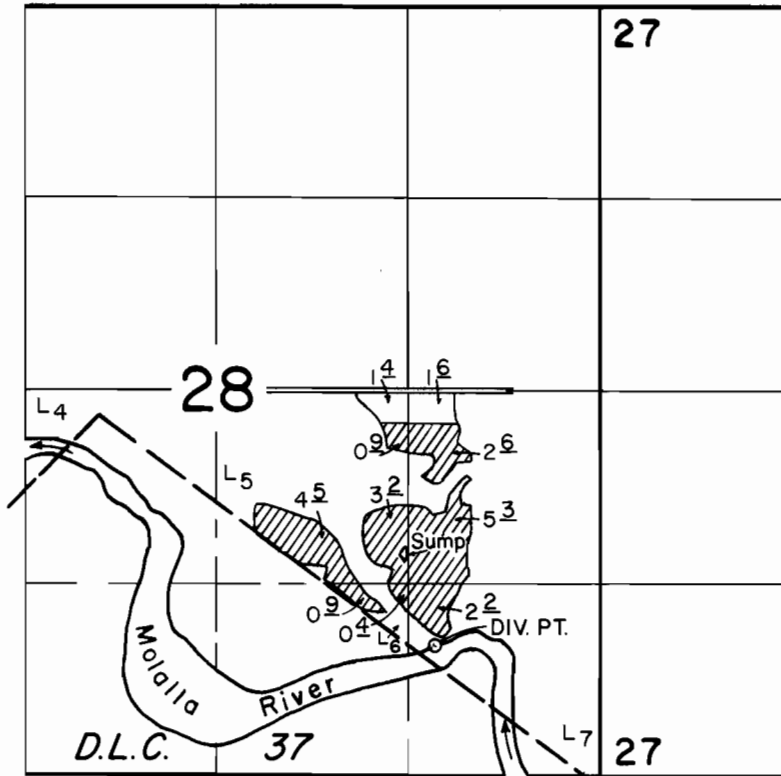

DIV. PT. LOC: 900' N. & 1140' W. FROM THE S.E. CORNER SEC. 28

SCALE: 1" = 1320'

FINAL PROOF SURVEY
UNDER

Application No. 64520.. Permit No. 47185.....
IN NAME OF

.....GARY FENSTERMACHER.....

Surveyed JULY 10, 1985., by T. WARREN.....