


T.41S., R.13W., W.M.

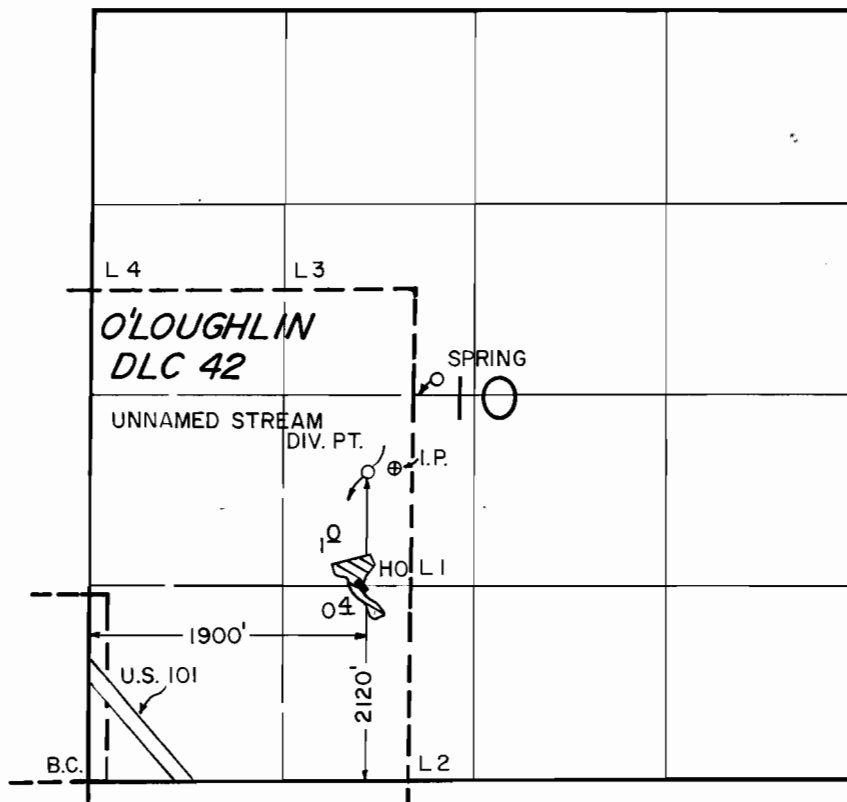

SPRING LOC 2750' N. & 2370' E. FROM THE S.W. COR. SEC. 10.

SCALE 1" = 1320'

FINAL PROOF SURVEY UNDER

Application No. 56133 55012 Permit No. 42277 SUPPLEMENTAL 41270 PRIMARY
 IN NAME OF

JOHN AND DOROTHY DECK

Surveyed APRIL 10 1985, by B. S. JAMES