


T.26S., R.6W., W.M.

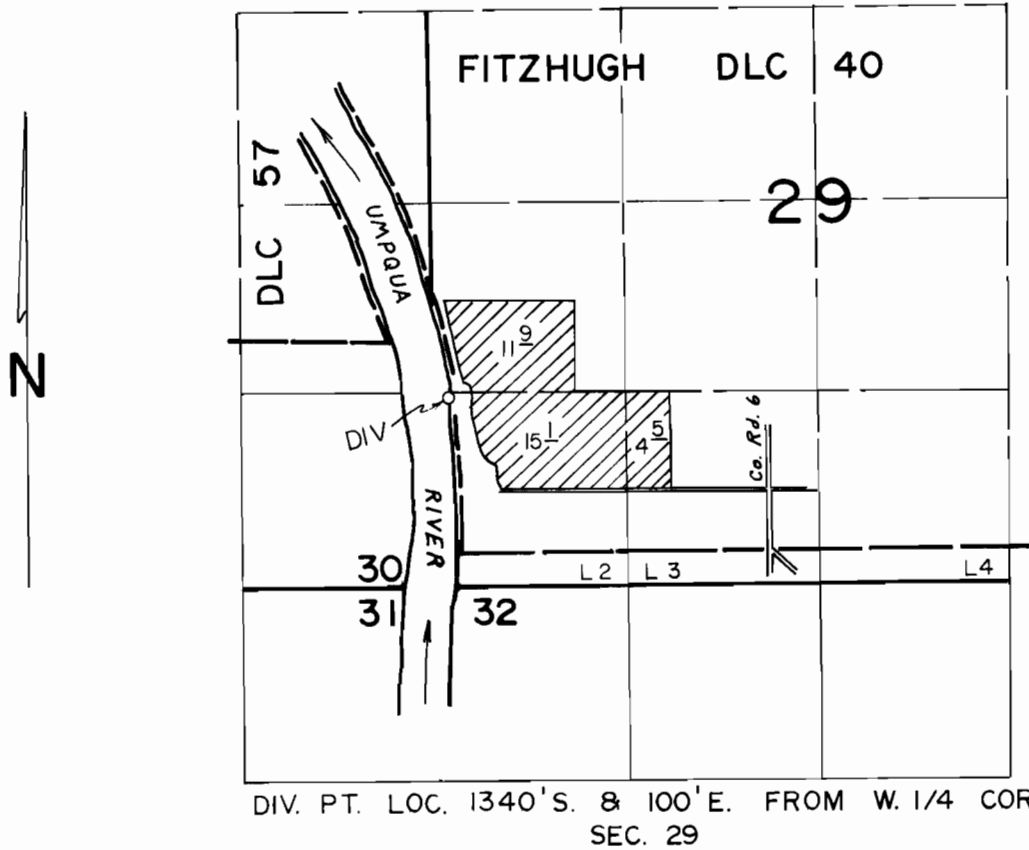

SCALE: 4" = 1 mile

FINAL PROOF SURVEY
UNDER

Application No. 63945.. Permit No. 47017.....
IN NAME OF

SHIRLEY HERCHER & PAULA GERVAIS

Surveyed MAY...7... 19.84, by *J.E. Cashion*