


T. 30S., R. 2 W., W. M.

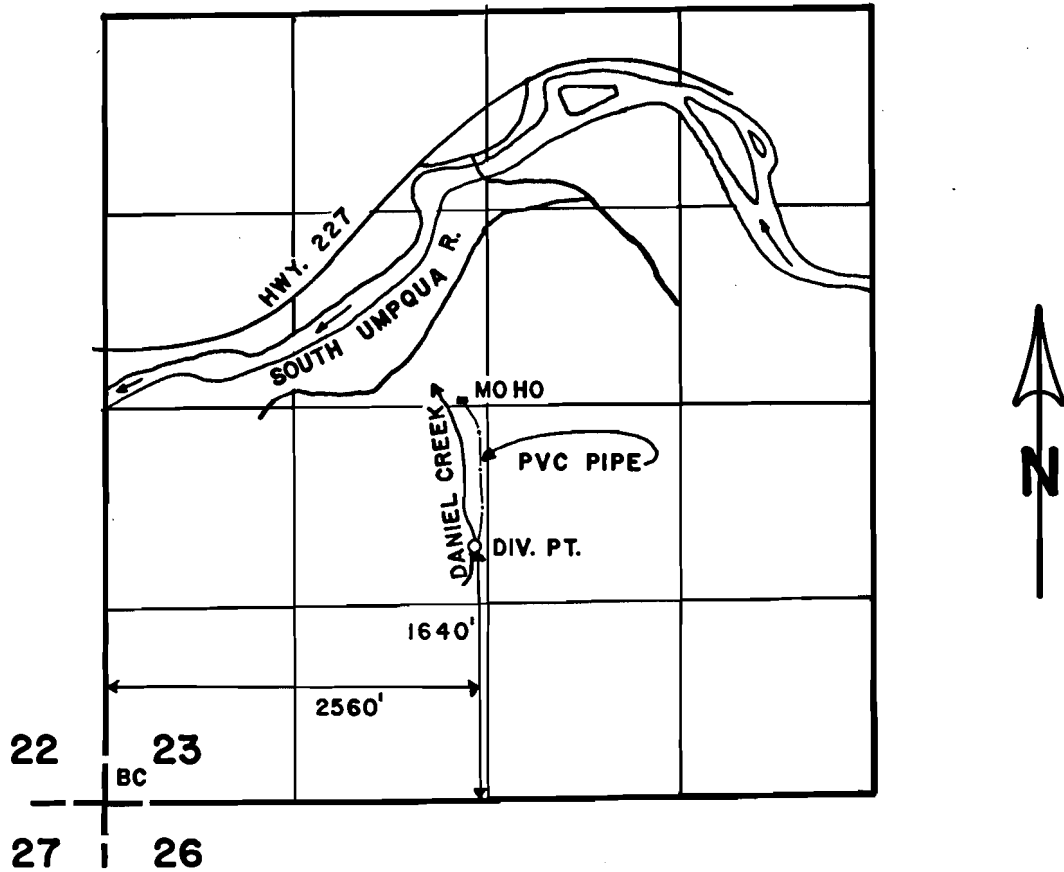

SCALE: 4" = 1 MILE

FINAL PROOF SURVEY UNDER

Application No. 64137 Permit No. 47108
IN NAME OF

STANLEY RICHARD ROBERTS.

Surveyed SEPT. 18, 1985, by J.M. SCHMORDE.