



T.37S. R.1W. W.M.

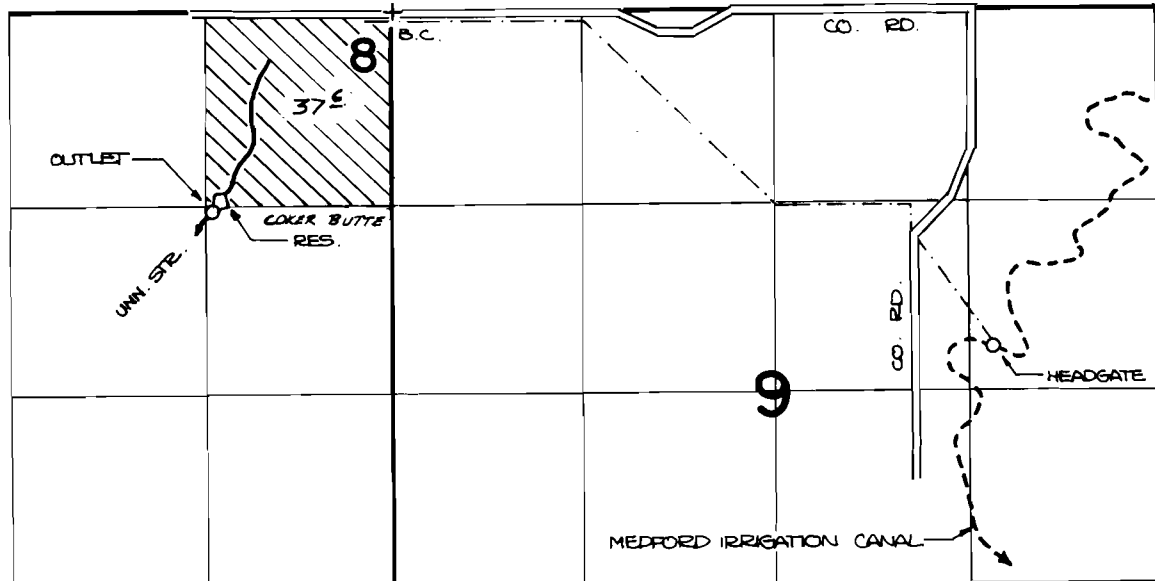

OUTLET IS LOCATED 1320' S. AND 1210' W. FROM THE N.E. CORNER OF SECTION 8.

T.36S. R.2E. W.M.

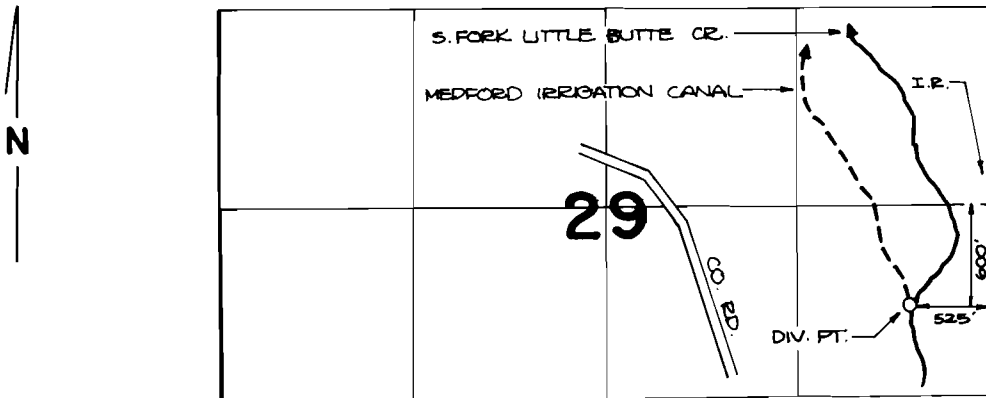

FINAL PROOF SURVEY UNDER

R-59356 R-7949
 Application No. **59357** Permit No. **44486**
 IN NAME OF

.....HIGHLANDS.....ORCHARD.....CO.....

Surveyed JUNE.9. 19.83, by ...B...JAMES....