


# T. 33 S., R. 2 E., W. M.

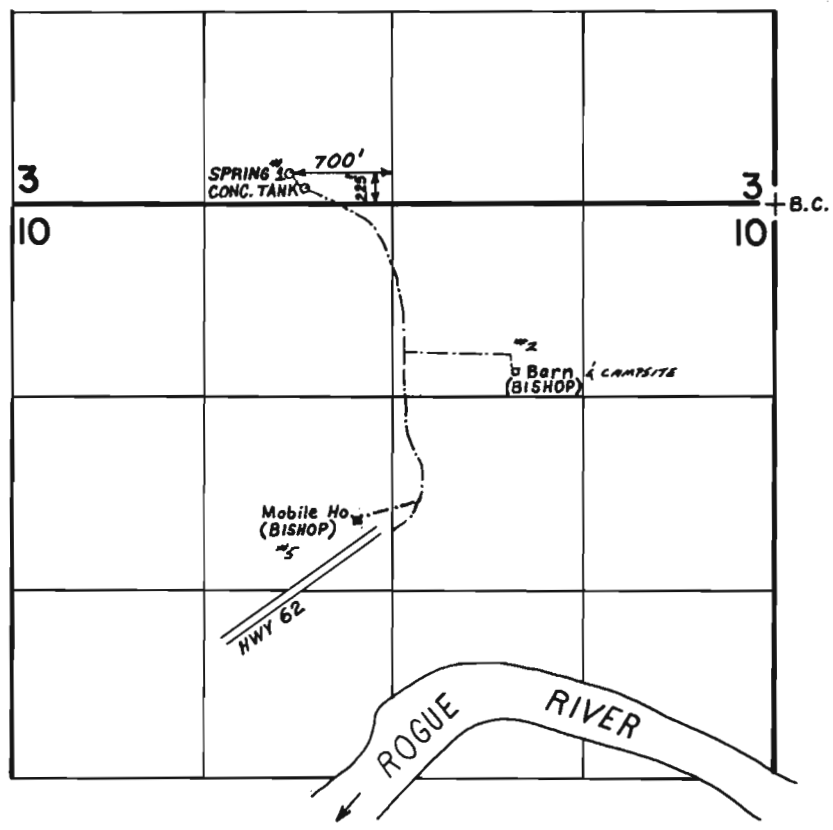

SCALE: 1" = 1320'

## FINAL PROOF SURVEY UNDER

TRANSFER NO. 2625

Application No. .... Permit No. 15729

IN NAME OF

.....HOWARD A. BISHOP.....

Surveyed MAY 26, 1983, by B.S. JAMES.....

C-15306  
Pr. 12-16-43  
Find in: Basin 15-Vol. 1A  
Rogue River Misc.