


# T. 36 S., R. 1 E., W. M.

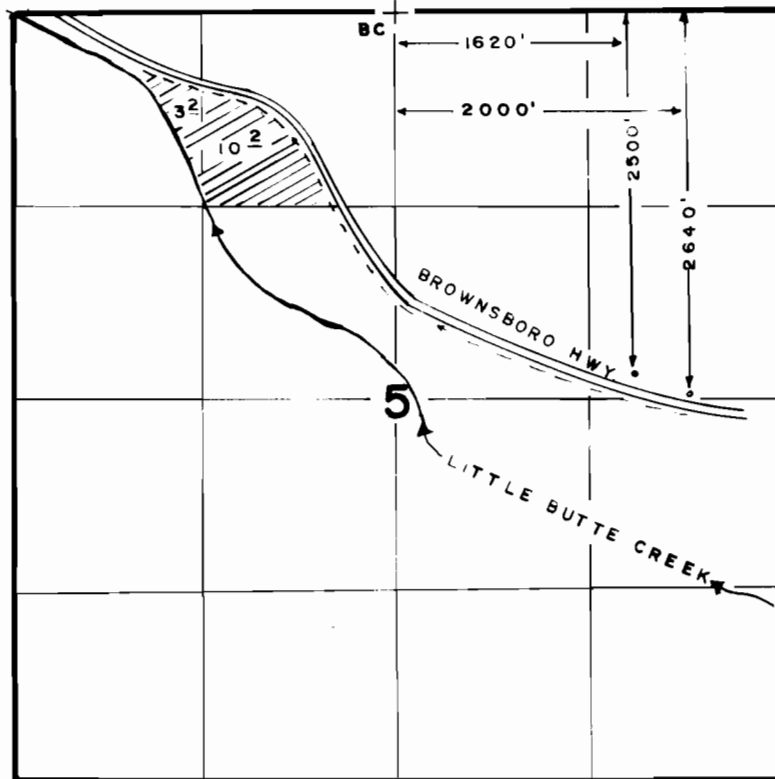

SCALE: 4" = 1 MILE

## FINAL PROOF SURVEY UNDER

Application No. 51222 Permit No. 39384  
IN NAME OF

MARIE E. & WILLIAM T. KANE

Surveyed OCT. 7 1985, by B. S. JAMES