
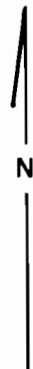


T. 32 S., R. 3 E., W. M.

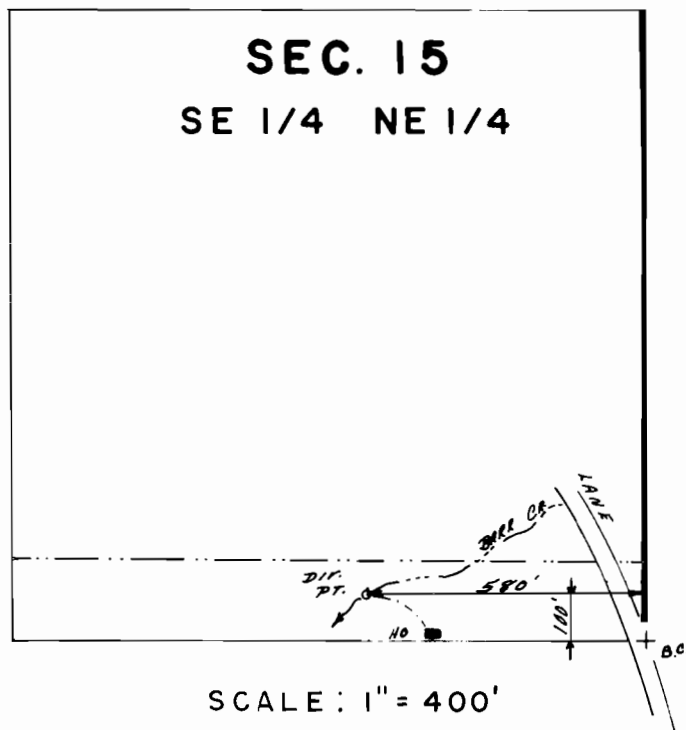

FINAL PROOF SURVEY
UNDER

Application No. **52510**.. Permit No. **39636**..
IN NAME OF

WILLIAM E. & OR KATHLEEN MONOHAN

Surveyed **OCT. 31, 1985**, by **B.S. JAMES**..