


T. 38S., R. 4W., W. M.

SEC. 32

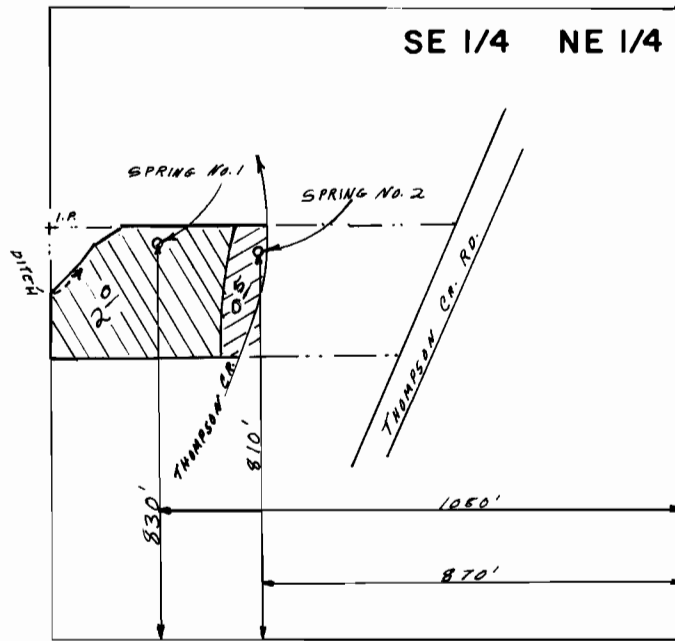

SCALE: 1" = 400'

FINAL PROOF SURVEY
UNDER

Application No. 589.7.3. Permit No. 4.4.4.3.3..
IN NAME OF

LARRY FRANCIS

Surveyed OCT. 3. 19.85, by B. S. JAMES...