


T.38S., R.4W., W.M.

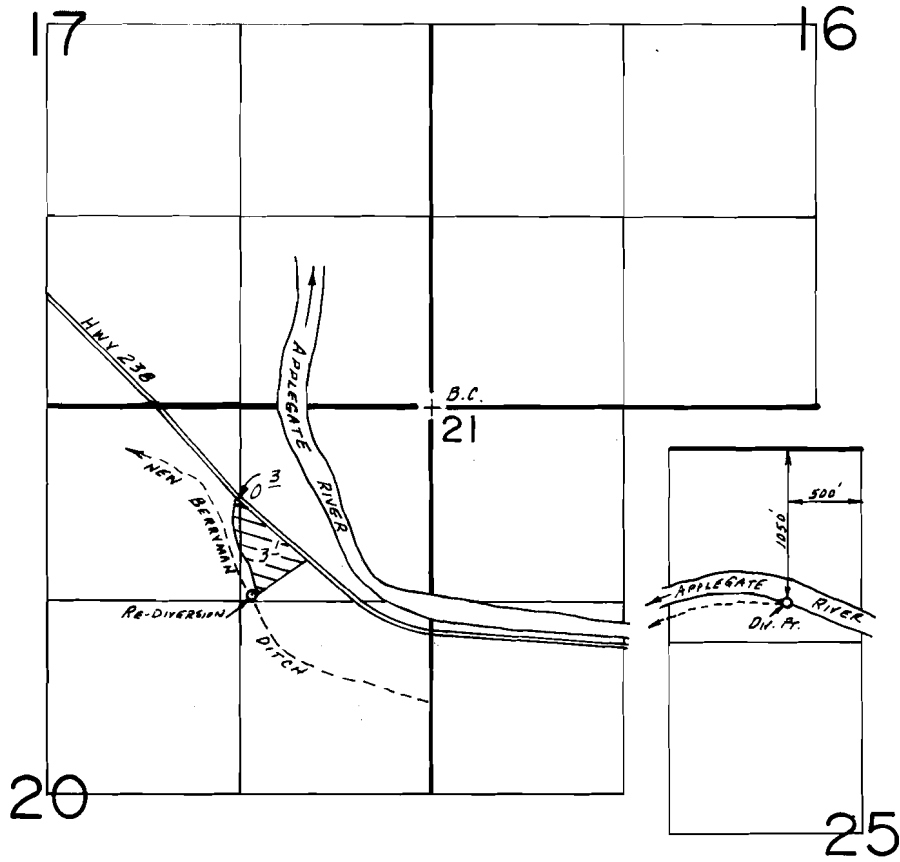

SCALE: 1" = 1320'

FINAL PROOF SURVEY
UNDER

Application No. ~~62329~~.. Permit No. ~~46487~~.....
IN NAME OF

.....DONALD R. BROWN.....

Surveyed Aug. 8..... 19.85, by ..R.S. JAMES.....