


T. 33 S., R. 6 W., W.M.

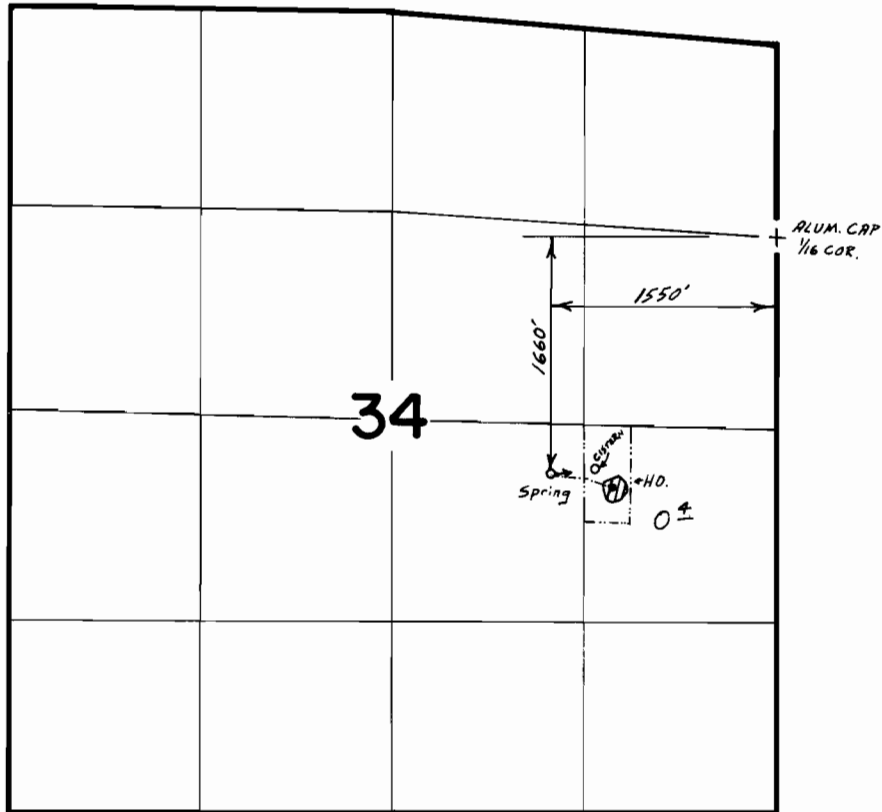

Scale 4" = 1 Mile

FINAL PROOF SURVEY
UNDER

Application No. 51775... Permit No. 39136.....
IN NAME OF

HERMES RAINBOW... SOLOMON... &... KATHLEEN SMITH HARRY

Surveyed Sept. 12, 1984, by J.R. WOODROOF
" Feb 14 1985 BS James