


T. 39S., R. 8W., W.M.

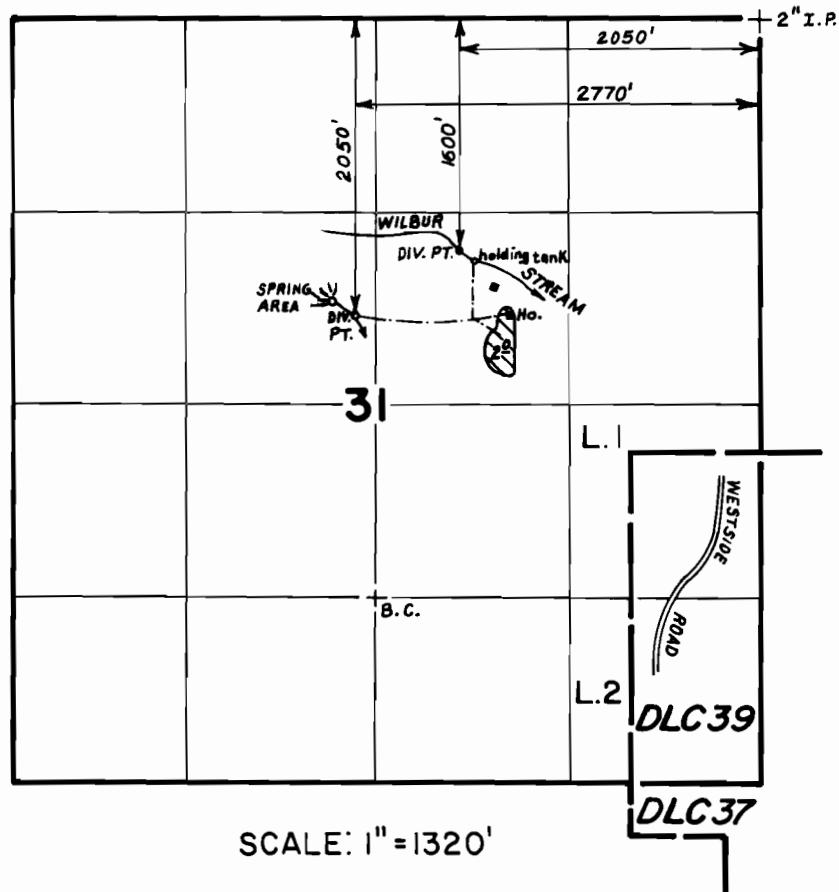

FINAL PROOF SURVEY UNDER

Application No. **59536** Permit No. **44980**
60379 **45759**
IN NAME OF

ROBERT AND JEANNIE BEADLING

Surveyed **MAR. 29, 1984**, by **B. S. JAMES**