


T.26S.,R.16E.,W.M

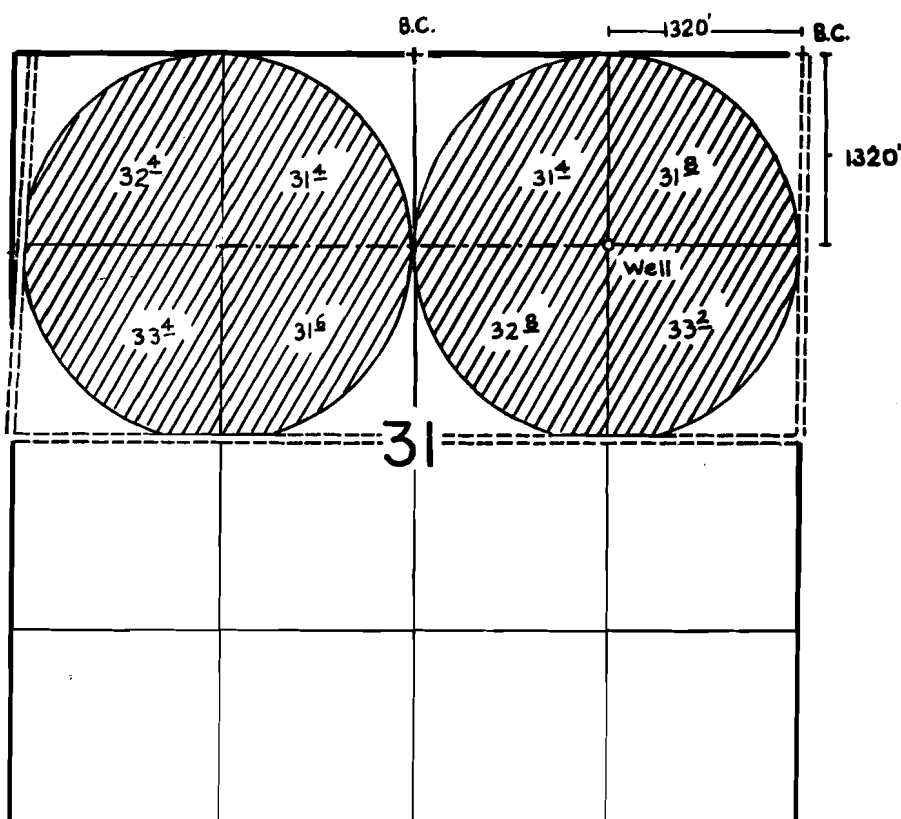

SCALE: 1"=1320'

FINAL PROOF SURVEY

UNDER

Application No. G-10852. Permit No. G-10006...
IN NAME OF

FLOWERREE FARMS, INC.

Surveyed APRIL 18, 1985., by LESLIE OLSON....