


T . 16S . R . 3W . W . M .

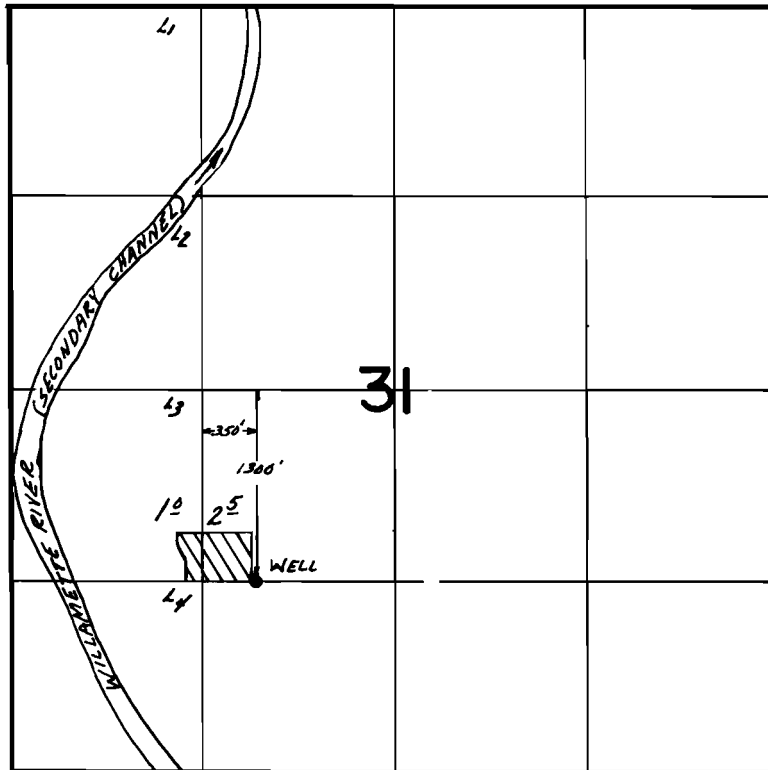

FINAL PROOF SURVEY
UNDER

TRANSFER No. 4069
Application No. G-8630 Permit No. G-7948...
IN NAME OF

.....WILDISH...LAND...Co.....

Surveyed May...17.. 1979, by S.C. BROWN.....