
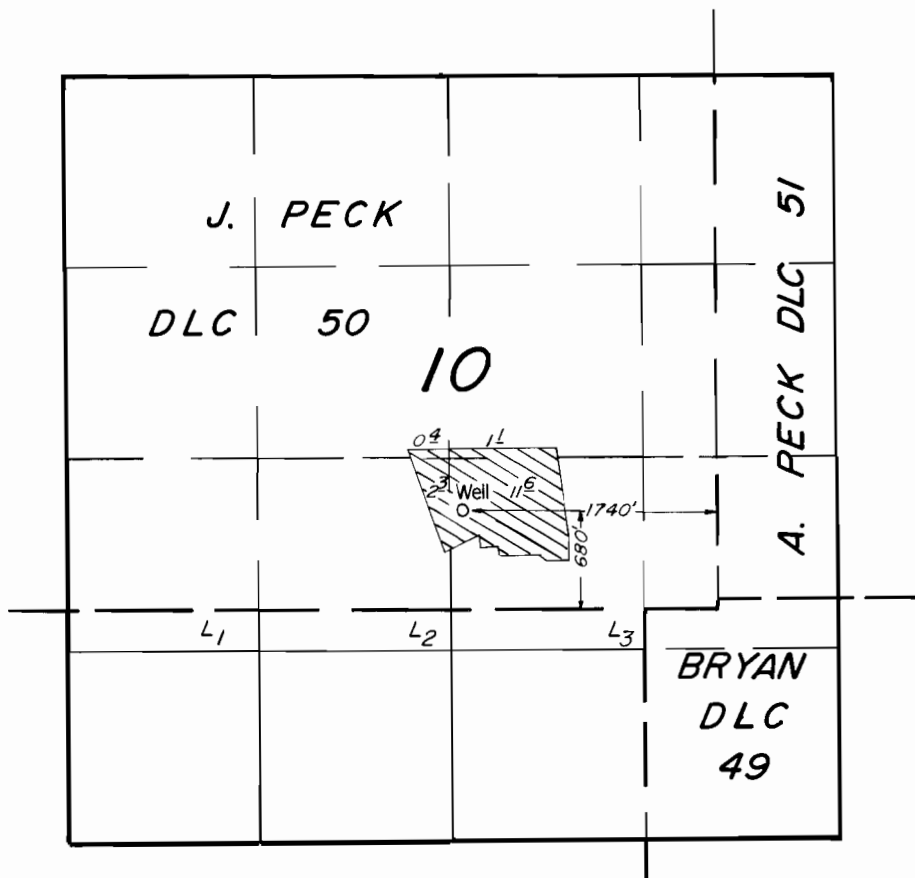


T. 17S., R. 4W., W.M.

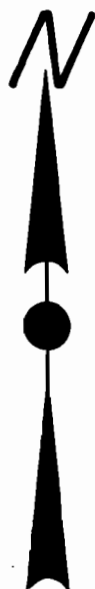

Scale: 1" = 1320'

FINAL PROOF SURVEY
UNDER

Application No. G-11303.. Permit No. G-10446..
IN NAME OF

EAGLES LODGE AERIE # 275

Surveyed May 22, 1985, by T. Warren