


T. 9S., R. 2E., W. M.

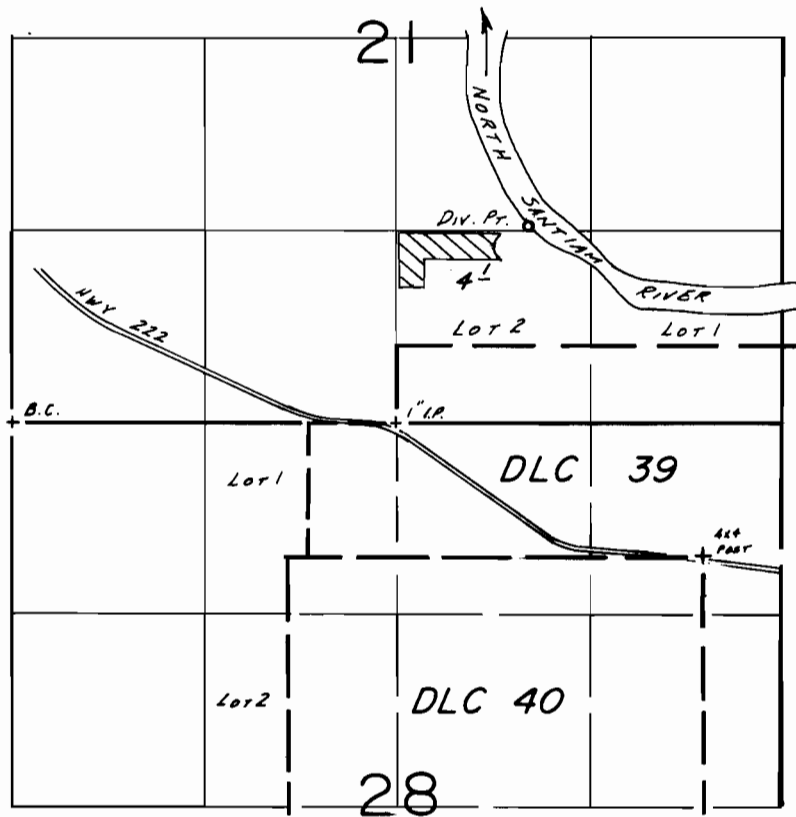

Div. Pr. Loc.: 1350' N. & 900' E. FROM S 1/4 COR. SEC. 21.

SCALE: 1" = 1320'

FINAL PROOF SURVEY UNDER

Application No. 59283.. Permit No. 44729.....
IN NAME OF

RALPH JAY & JUANITA L. DAVIS

Surveyed May. 28.. 1986, by B.W. BISHOP.....

11/13/06
BWB