


T.12 S., R.3 W., W.M.

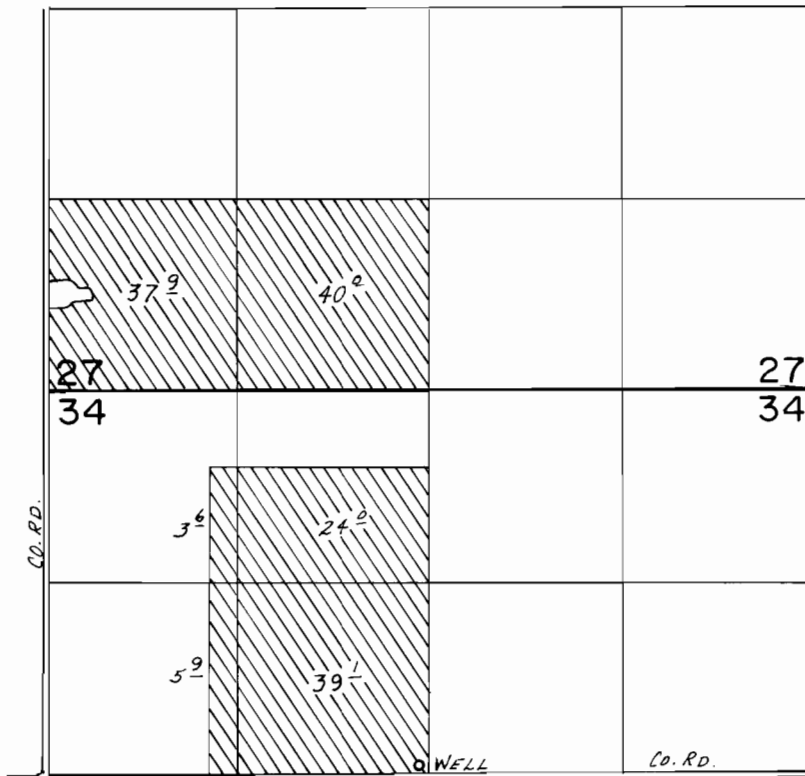

WELL LOC.: 70' N. & 2540' E. FROM W 1/4 COR. SEC. 34.

SCALE: 1" = 1320'

FINAL PROOF SURVEY UNDER

Application No. G:10085 Permit No. G:9139.....
IN NAME OF

.....JOHN R. KOOS & SONS.....

Surveyed June 7, 1984, by L.M. TOLL.....